


T.21S. R.5W.W.M.

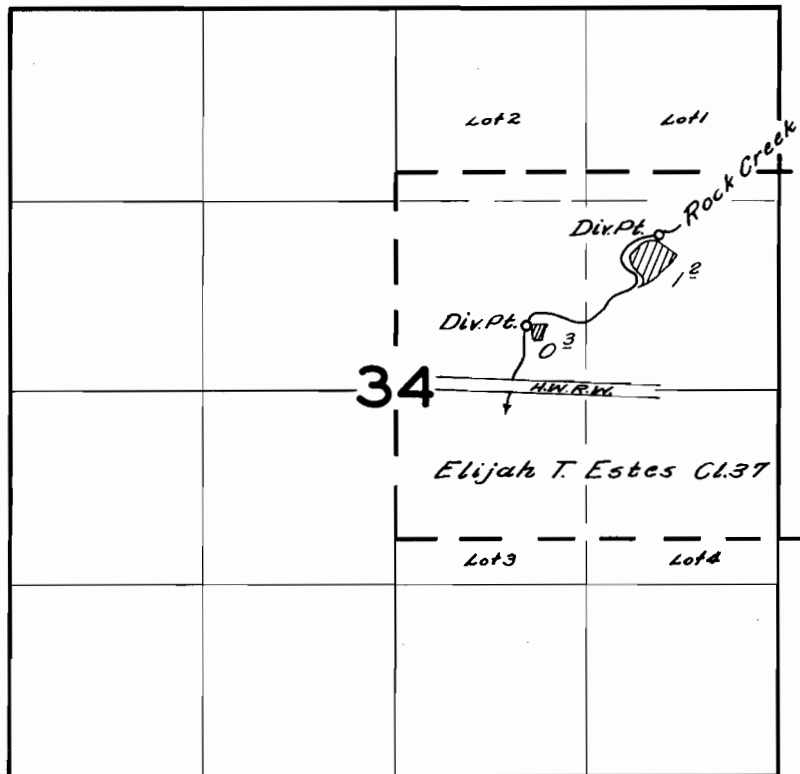

FINAL PROOF SURVEY
UNDER

Application No. 27606.. Permit No. 21747...
IN NAME OF

.....ELDON POWELL.....

Surveyed April 19 1957, by C.D. Bartels