


T. 19S. R. 1W. W.M.

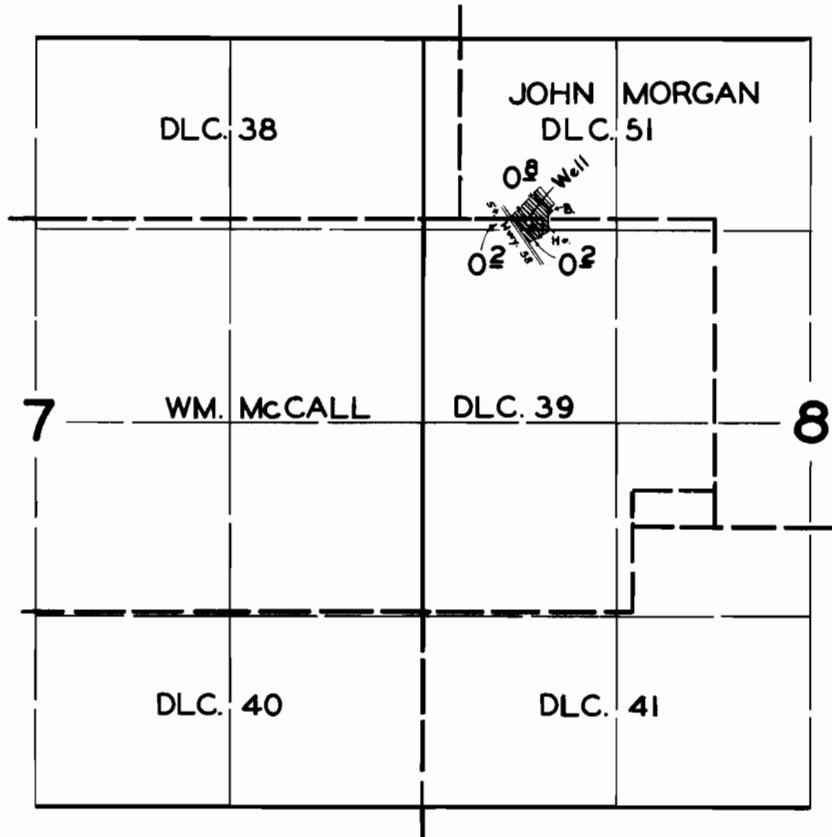

FINAL PROOF SURVEY
UNDER

Application No. G-1152 Permit No. G-1103
IN NAME OF

CECIL S. & VERL E. WOODS

Surveyed APR. 2. 1959, by M. BISH