


T17S R2WWM

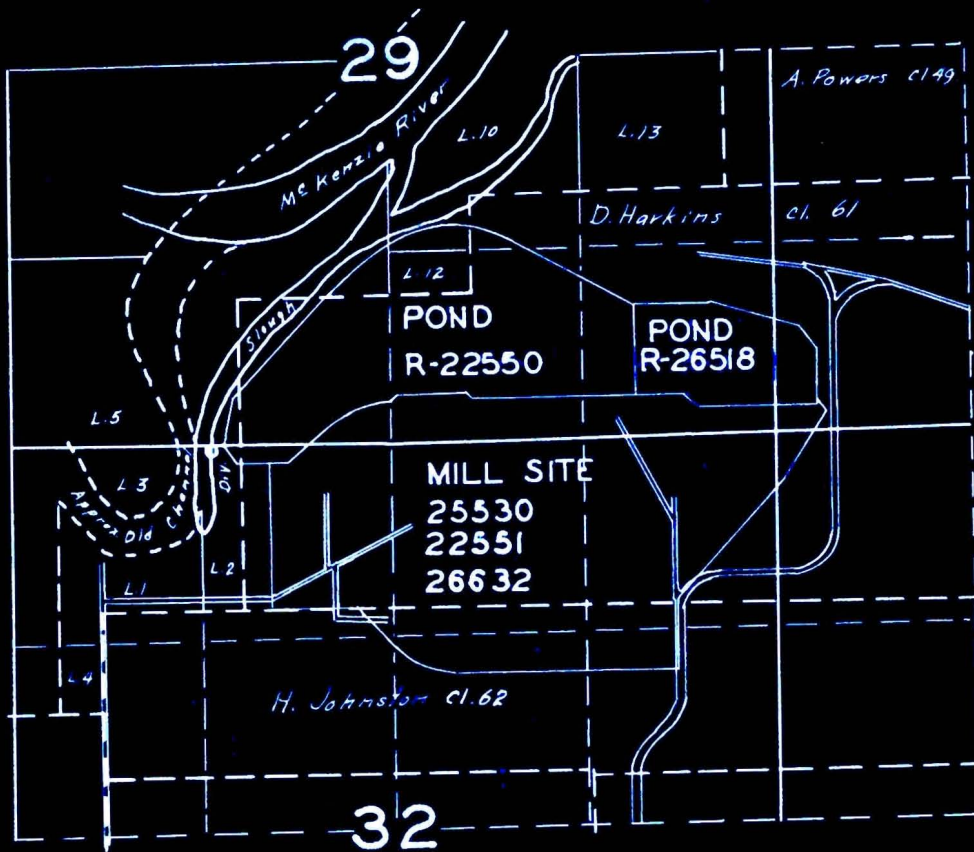

FINAL PROOF SURVEY

UNDER

22551
R-22550
R-26518
25530
26632

Application No. _____ Permit No. _____
IN NAME OF _____

17511
R-861
R-1265
20053
20864

Meyerhaeuser Timber Company

Surveyed April 22-1954, by T. Jones