


T. 15&16S. R. 4W.W.M.

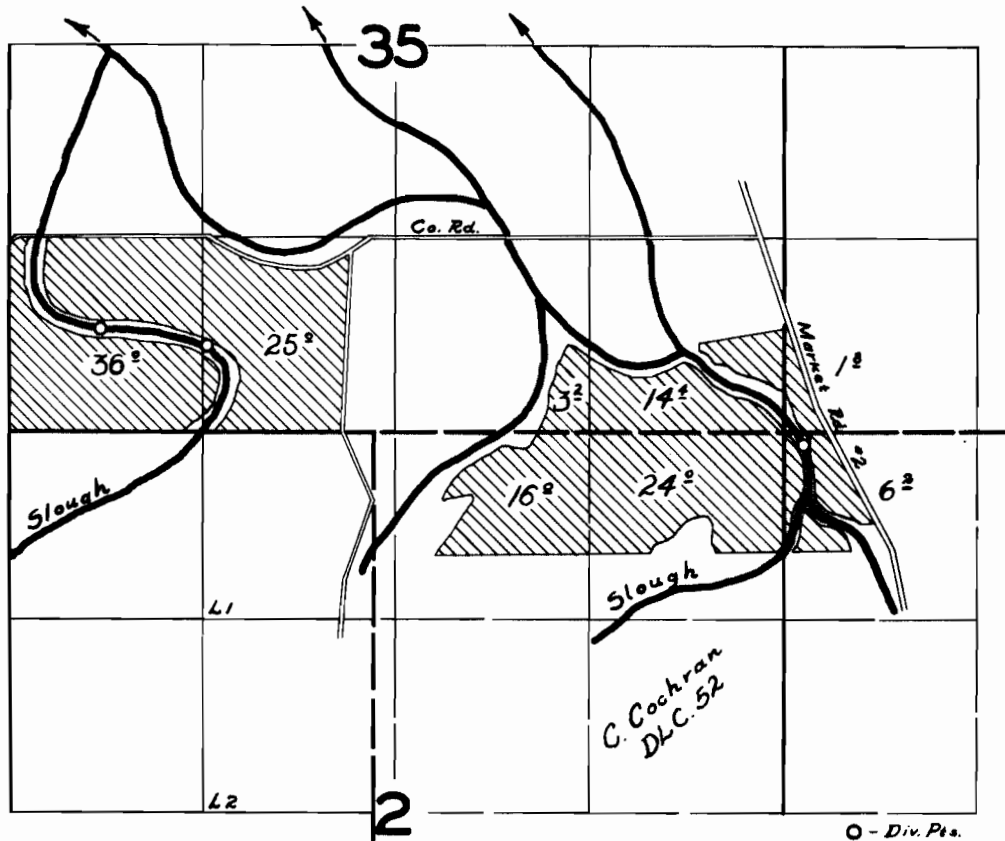

FINAL PROOF SURVEY

UNDER

Application No. 27983 Permit No. 22026

IN NAME OF

Gerald W. & Marie Detering

Surveyed Sept. 2 19 59 by C. O. Bartels