


T. 5 & 6 S. R. 1 W. W. M.

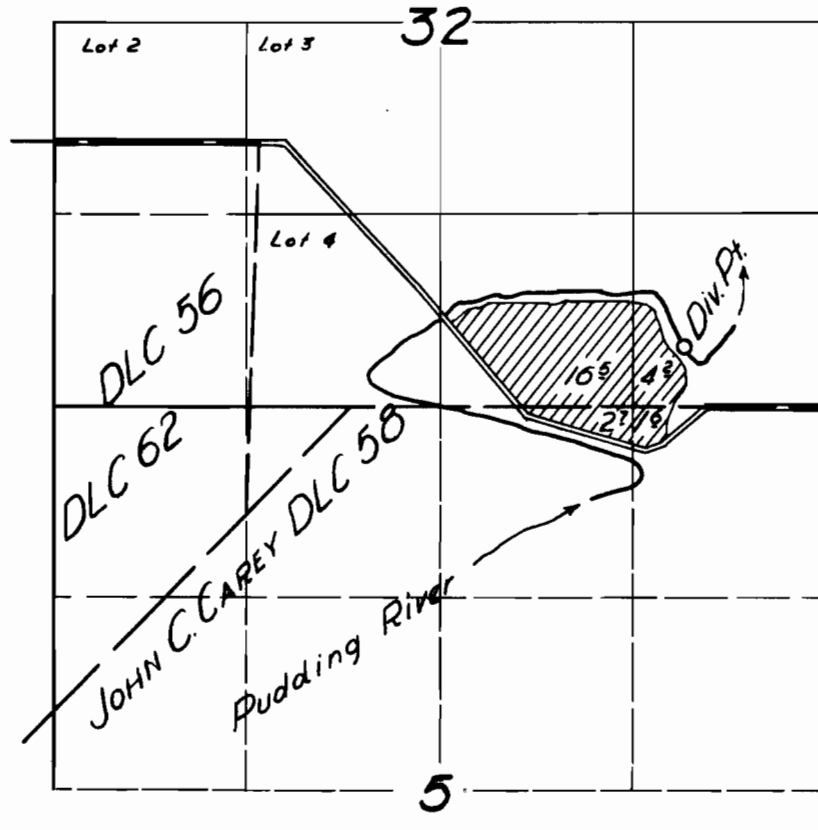

**FINAL PROOF SURVEY**

UNDER

Application No. 19256 Permit No. 14835

IN NAME OF

JOHN FRANK

Surveyed 8 June 1956, by [Signature]