


T.7S.R.5W.W.M.

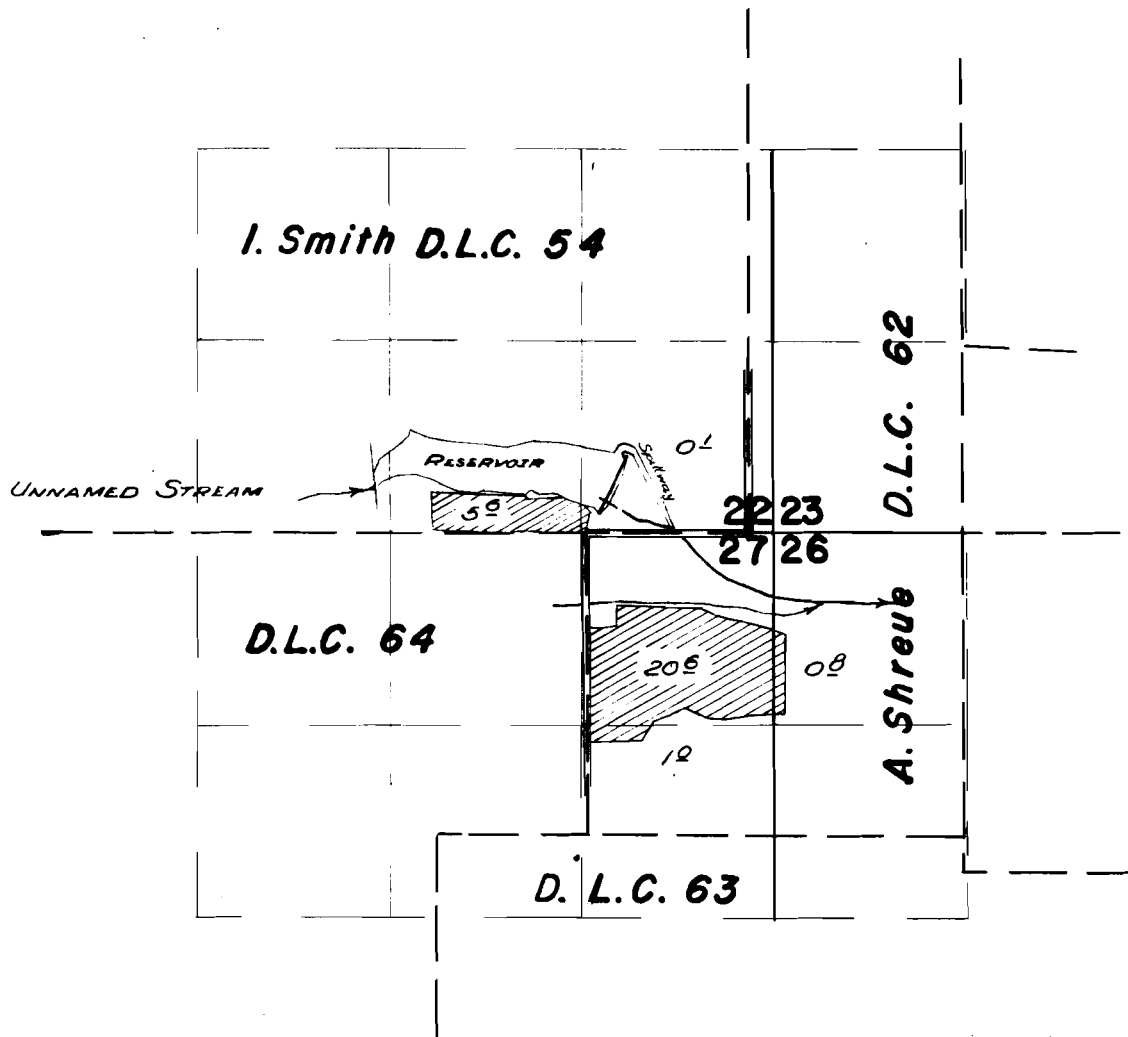

FINAL PROOF SURVEY UNDER

31729 25012
Application No. R-31728 Permit No. R-2045
IN NAME OF

ABE EDIGER

Surveyed 27+28 MAR. 1961, by *m. Bick*