


T.8 S.R.6 W.W.M.

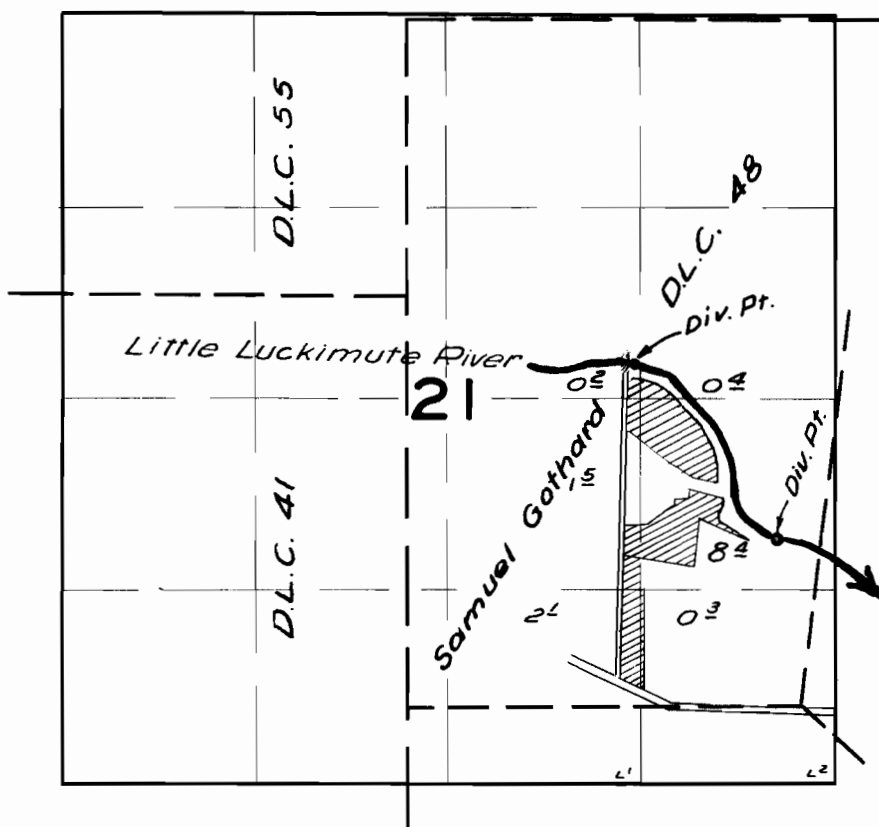

FINAL PROOF SURVEY UNDER

Application No. 24260 Permit No. 19042
IN NAME OF

EARLE & HELEN L. SCHOONOVER

Surveyed 24 Apr. 1958, by R. H. Whitby