


# T.4SR9&10 W. W. M.

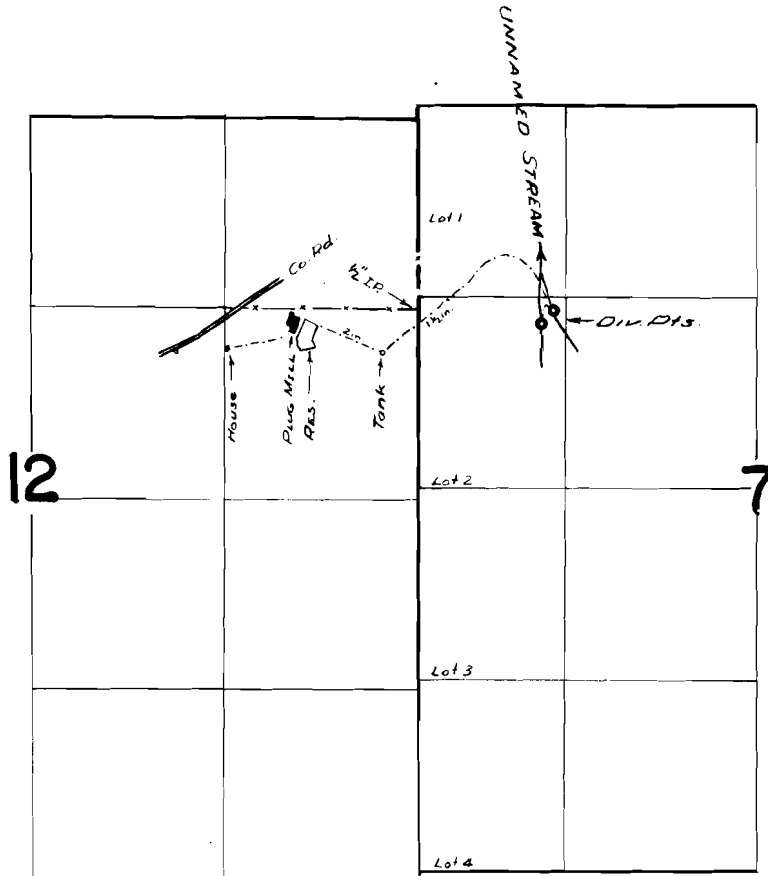

## FINAL PROOF SURVEY UNDER

Application No. <sup>31007</sup> ~~P-30880~~ Permit No. <sup>24388</sup> ~~P-1896~~  
IN NAME OF

*MARVIN B. & EVA L. NOBLE*

Surveyed 28 June 1961, by *M. Bish*