


T.2S. R. 40E.W.M.

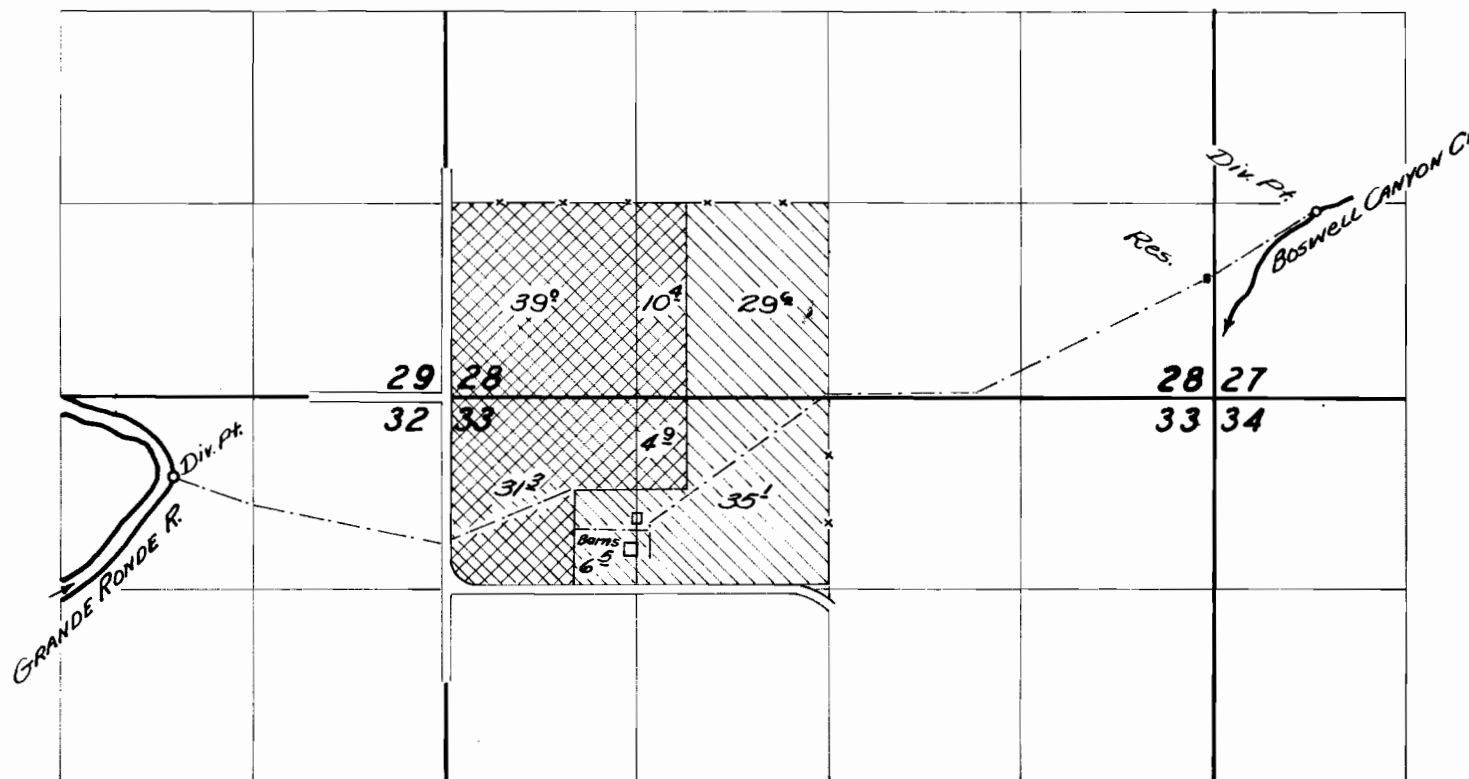

FINAL PROOF SURVEY

UNDER

Application No. ^{R-24561}
²⁴⁶⁰⁹ ~~23433~~ Permit No. ^{R-1025}
¹⁹³⁸² ~~22282~~

IN NAME OF

HARLOW C. & MELBA HONSTADT

Surveyed Aug. 13, 1959., by C. V. Bartlett