


T.3S.R.38E.W.M.

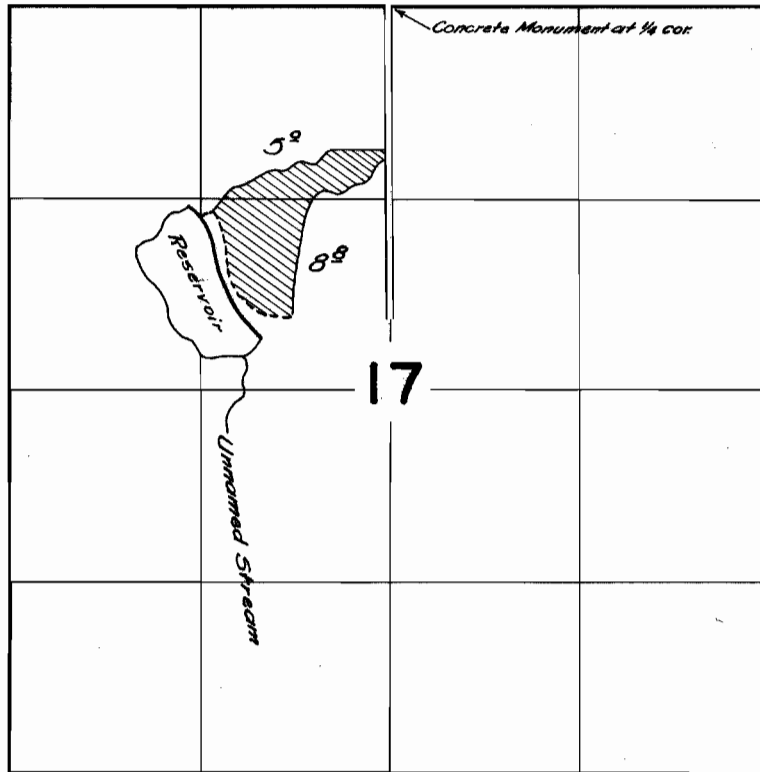

FINAL PROOF SURVEY
UNDER

Application No. ^{R-29057} 29058... Permit No. ^{R-1630} 22973.
IN NAME OF

..... *G. W. Spence*

Surveyed Aug. 4, 1959, by *C. O. Bartels*