


T. 1 S. R. 3 W. W. M.

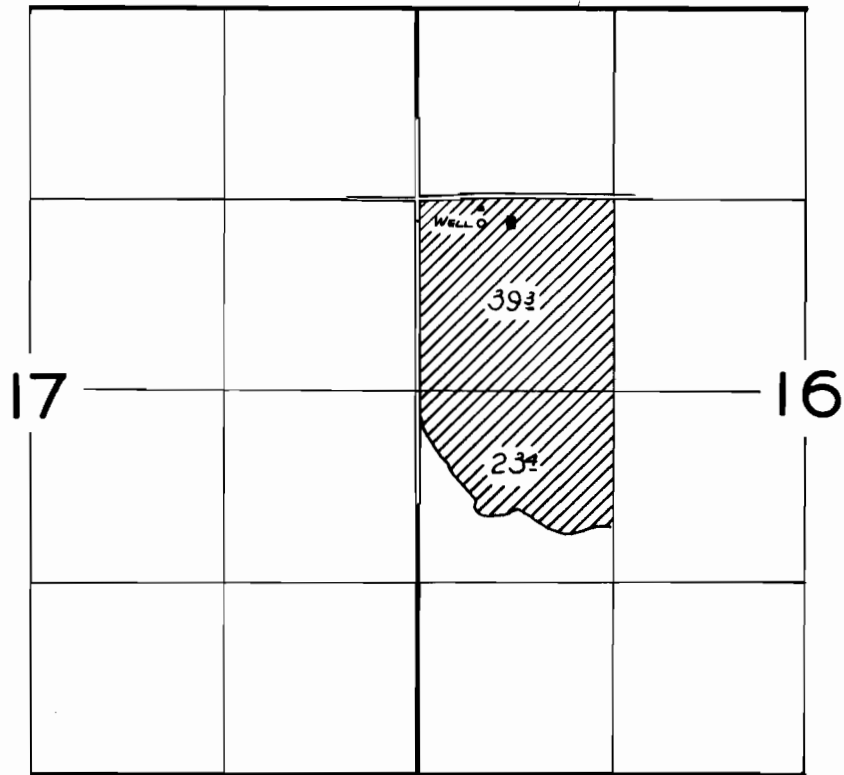

FINAL PROOF SURVEY
UNDER

Application No. *G-442*. Permit No. *G-391*.
IN NAME OF

VICTOR & HARNEY LORENZ

Surveyed *27 May* 1959, by *A. Jackson*