


T. 6N. R. 35E. W. M.

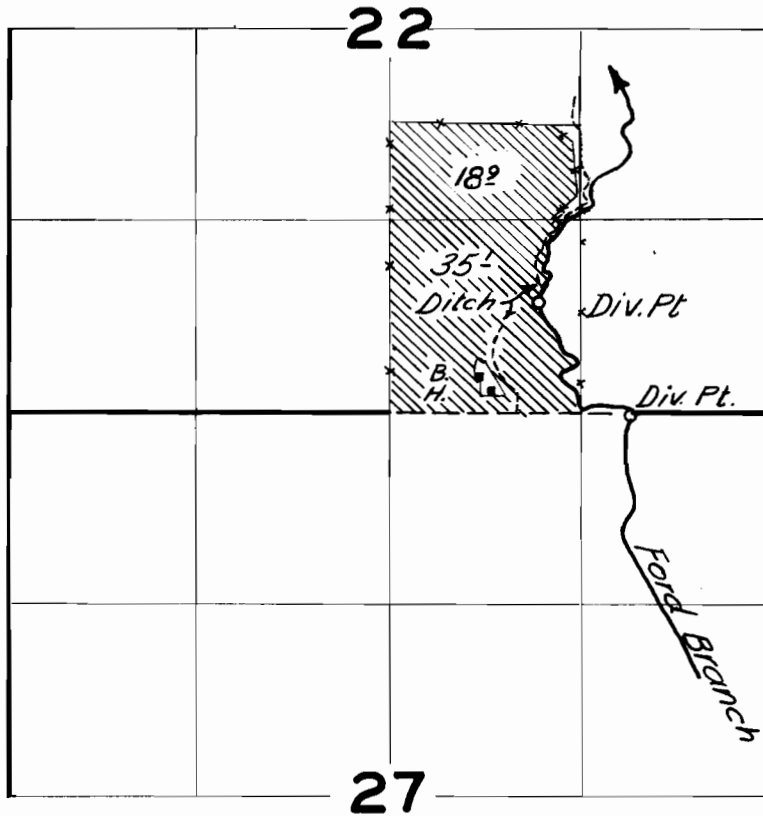

**FINAL PROOF SURVEY**

UNDER

Application No. \_\_\_\_\_ Permit No. 2317

IN NAME OF

Surveyed Aug 13 1911, by \_\_\_\_\_