


T. 30 S. R. 5 W. W.M.

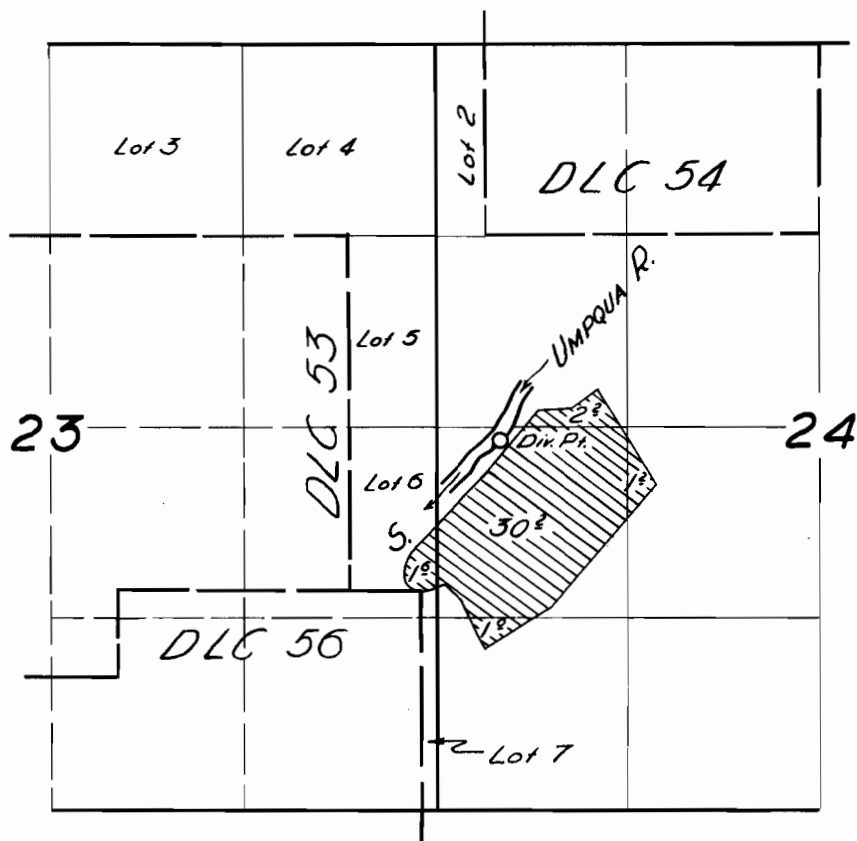

FINAL PROOF SURVEY
UNDER

Application No. 25681 Permit No. 20132

IN NAME OF

J. P. TALBOT

Surveyed 15 Oct 1956, by