


T.9 S.R.1 W. W.M.

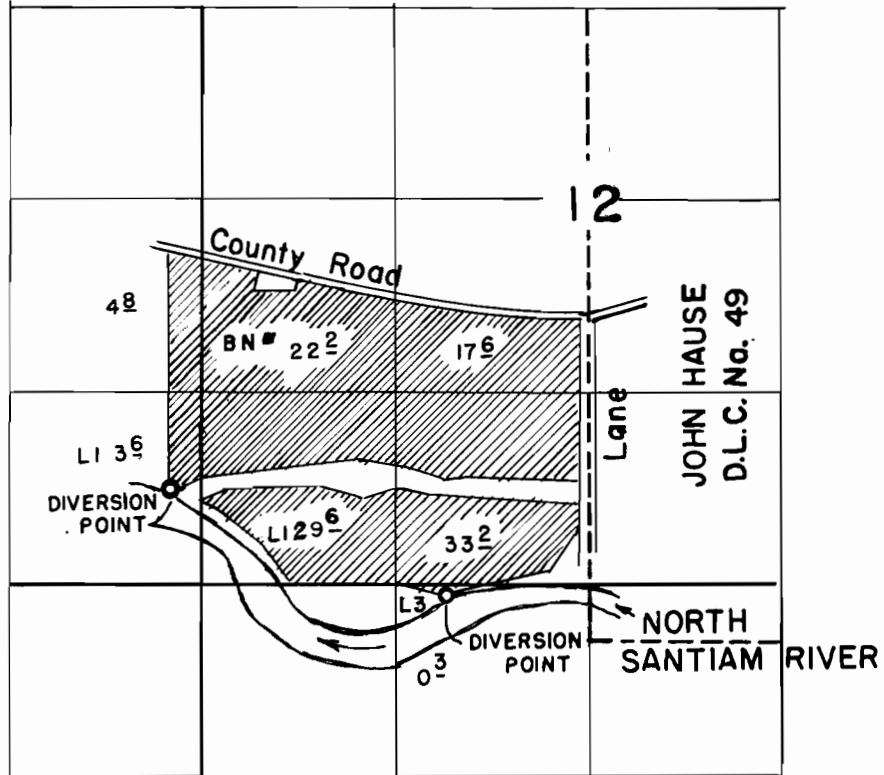

FINAL PROOF SURVEY
UNDER

30930 24342
Application No. 30631 Permit No. 24132
IN NAME OF

Zimmerman Brothers

Surveyed Oct. 26 1962, by *Floyd L. Sigmond*