


T.2N.R.3 W.W.M.

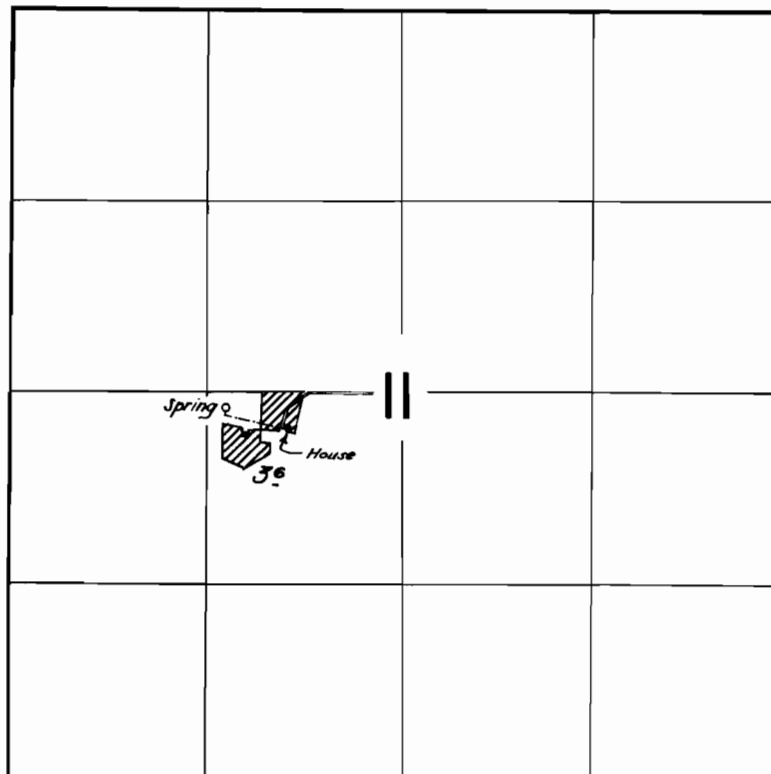

FINAL PROOF SURVEY
UNDER

Application No. **31163** Permit No. **24560**
IN NAME OF

IRVING B. & HERTA I. HICKMAN

Surveyed *July 24* 1961, by *C. Jackson*