


T. 3S. R. 3W. W.M.

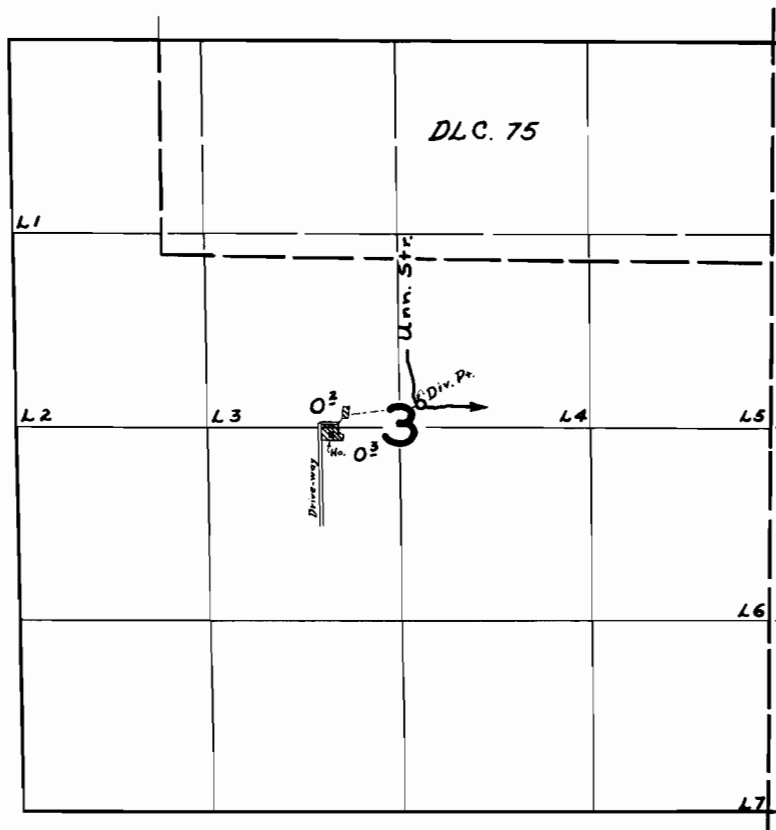

FINAL PHASE SURVEY


29787 Permit No. 23449

IN NAME OF

Earl G. Smith

Surveyed Sept. 10 19 59, by M. Bish