


T.40S. R.19E.W.M.

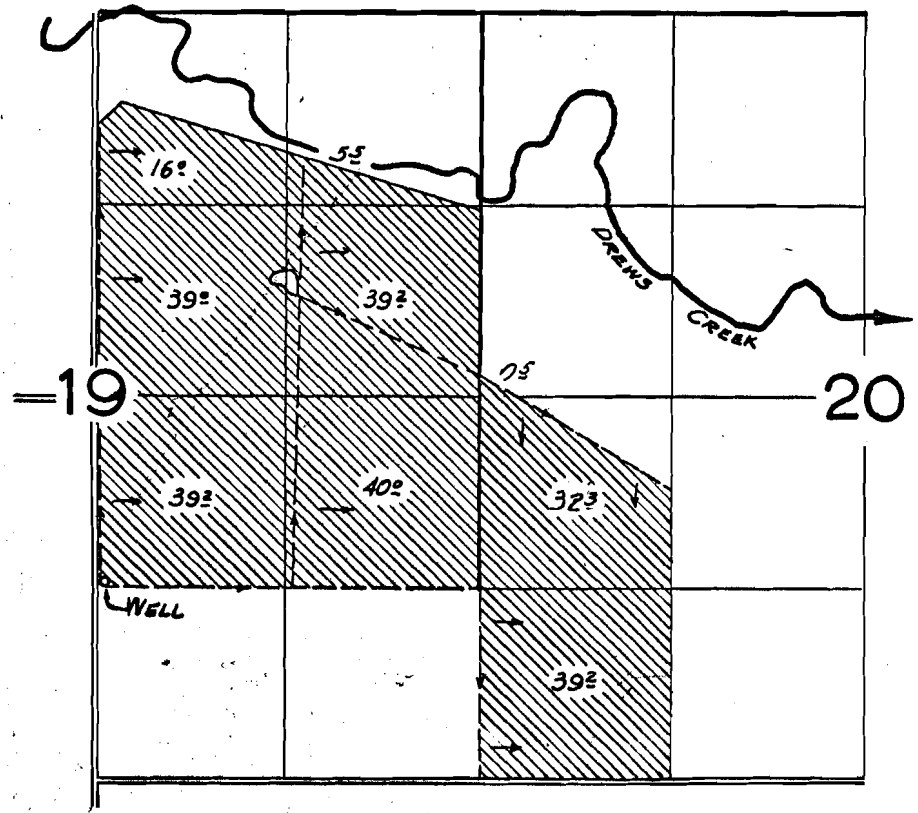

FINAL PROOF SURVEY UNDER

Application No. U-865 Permit No. U-753
IN NAME OF

CLYDE W. FENIMORE

Surveyed May 7 1959, by R.H. Jackson