


T.8S.R.40E.W.M.

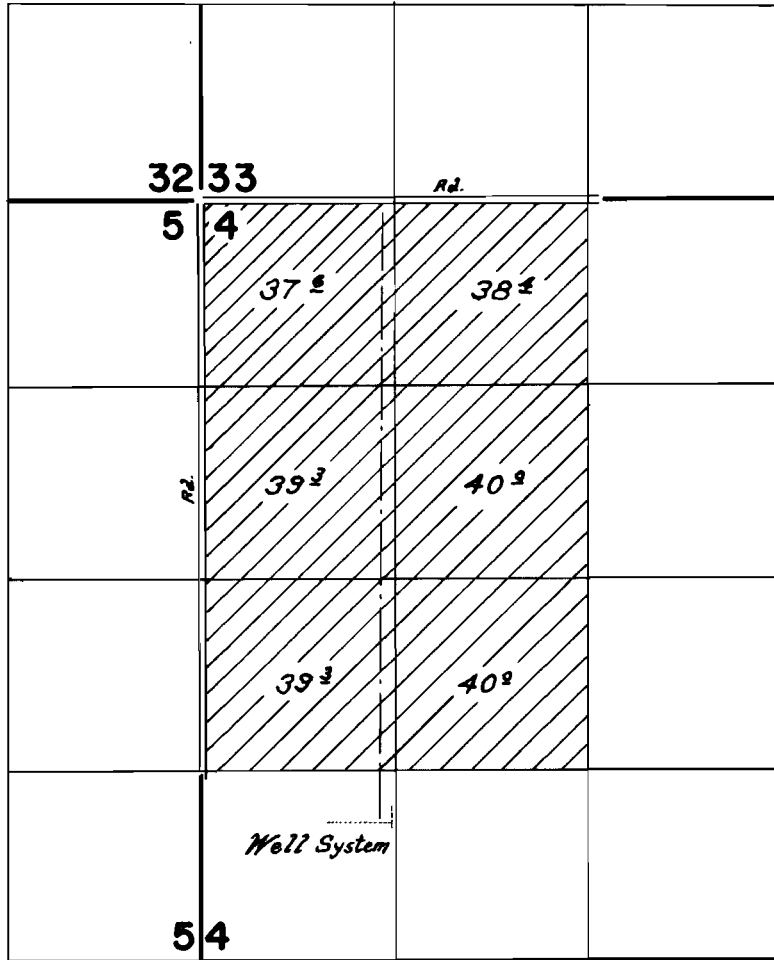

FINAL PROOF SURVEY UNDER

Application No. *G-988* Permit No. *G-872*
IN NAME OF

Charles M. Colton

Surveyed *July 12, 1962*, by *Thomas R. Lauer*