


T.7S.R.46E.W.M.

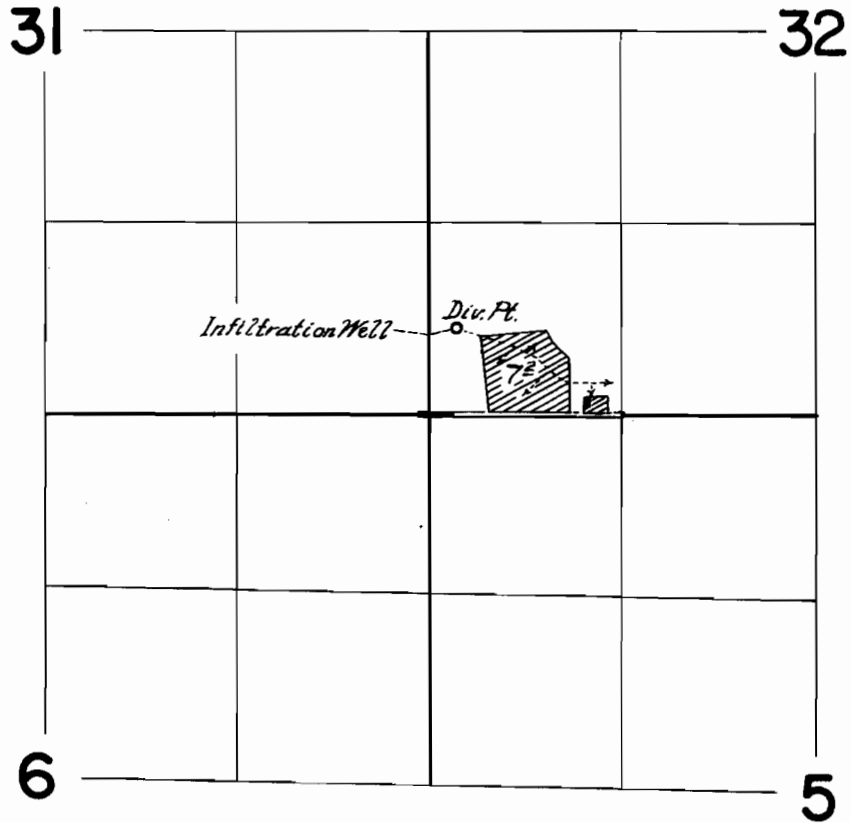

FINAL PROOF SURVEY
UNDER

Application No. G-1305 Permit No. G-1167
IN NAME OF

Lewis Laird

Surveyed July 17, 1962, by Thomas R. Lauer.