


T.12S. R.5W. W.M.

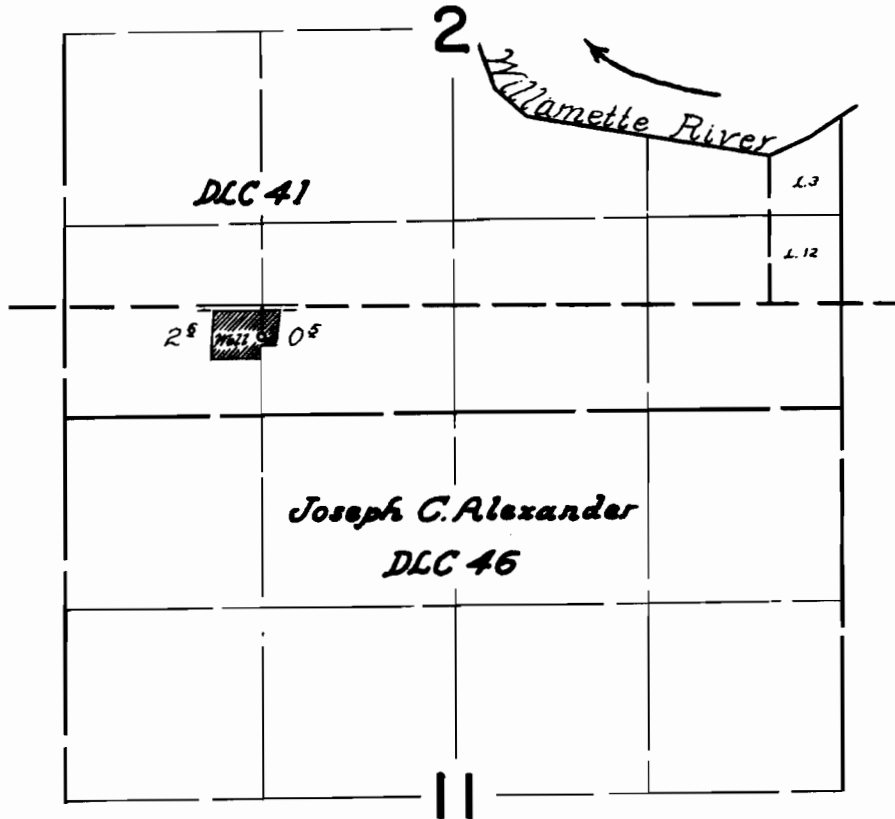

FINAL PROOF SURVEY
UNDER

Application No. *G-1804*. Permit No. *G-1650*
IN NAME OF

.....*E.S. Neville*.....

Surveyed *September 6 1962*, by *Thomas R. Lauer*