


T. 10S. R. 7W. W.M.

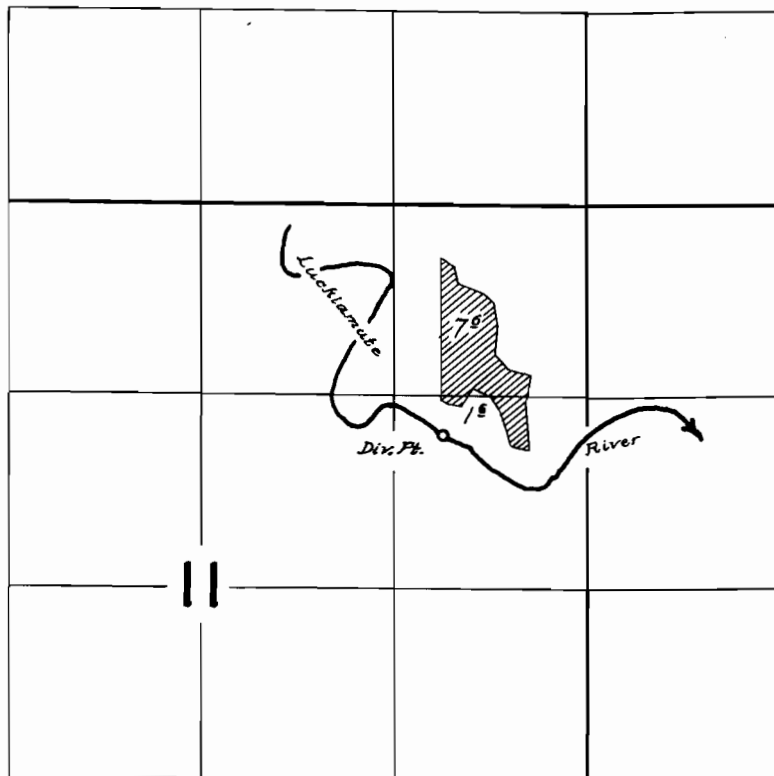

FINAL PROOF SURVEY UNDER

Application No. 31633 Permit No. 24935
IN NAME OF

Ernest Jensen & Edwin Tanner

Surveyed August 29 1962, by Thomas R. Lauer