


T.12S.R5W. W.M.

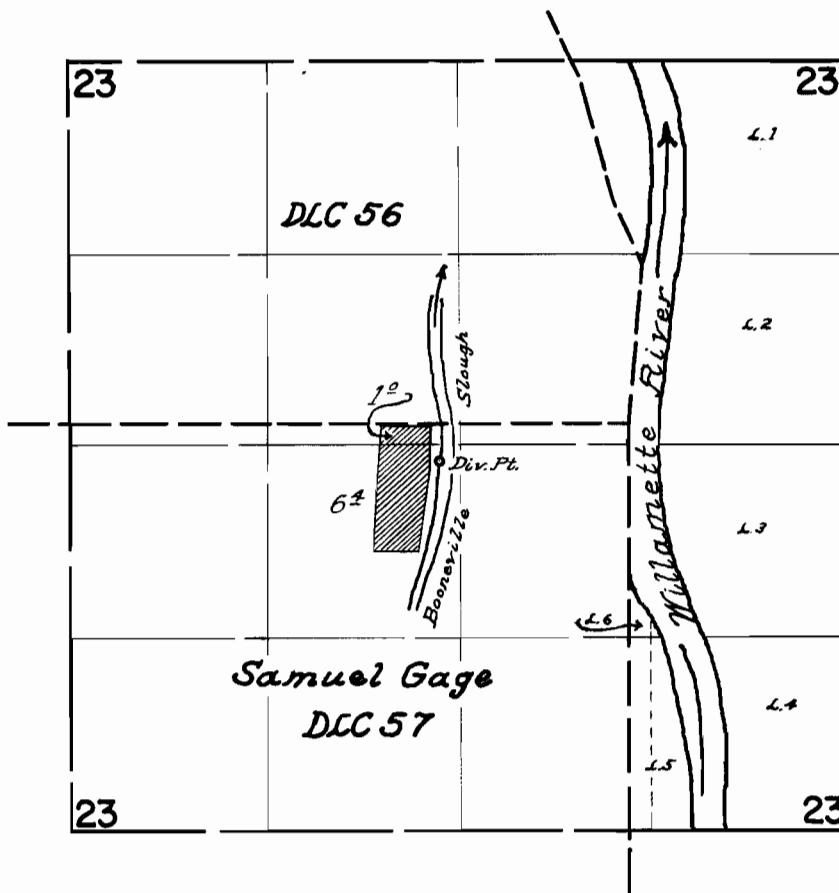

**FINAL PROOF SURVEY**  
UNDER

Application No. 32447 Permit No. 2562A  
IN NAME OF

Ervin Radke

Surveyed August 27, 1962, by Thomas R. Lauer