


T.I.S.R. 3E.W.M.

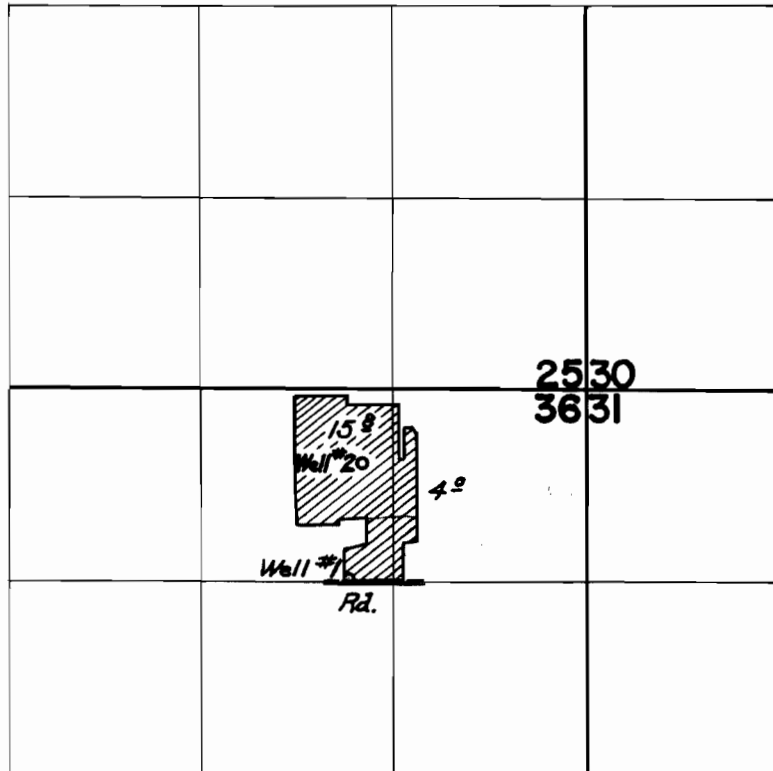

FINAL PROOF SURVEY UNDER

Application No. *G-1321* Permit No. *G-1143*
IN NAME OF

Walter Marx Gardens

Surveyed *May 29 1962*, by *Thomas F. Lauer*