


# T.5S.R.3E.W.M.

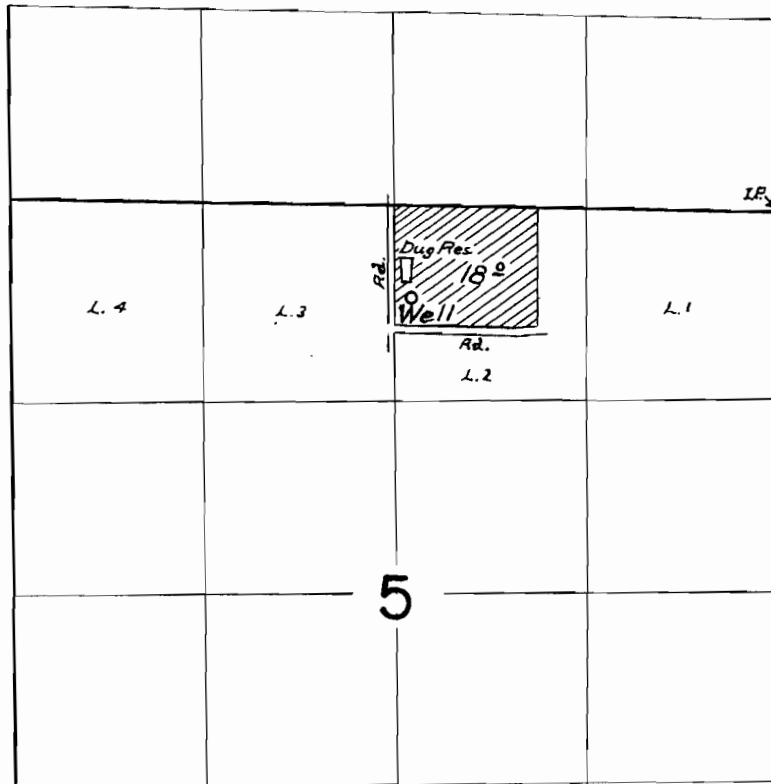

## FINAL PROOF SURVEY UNDER

Application No. *6-1729*. Permit No. *6-1628*.  
IN NAME OF

*Bennett W. Hood*

Surveyed *June 21, 1962*, by *Thomas R. Lauer*