


T. 4S. R. 3E. W.M.

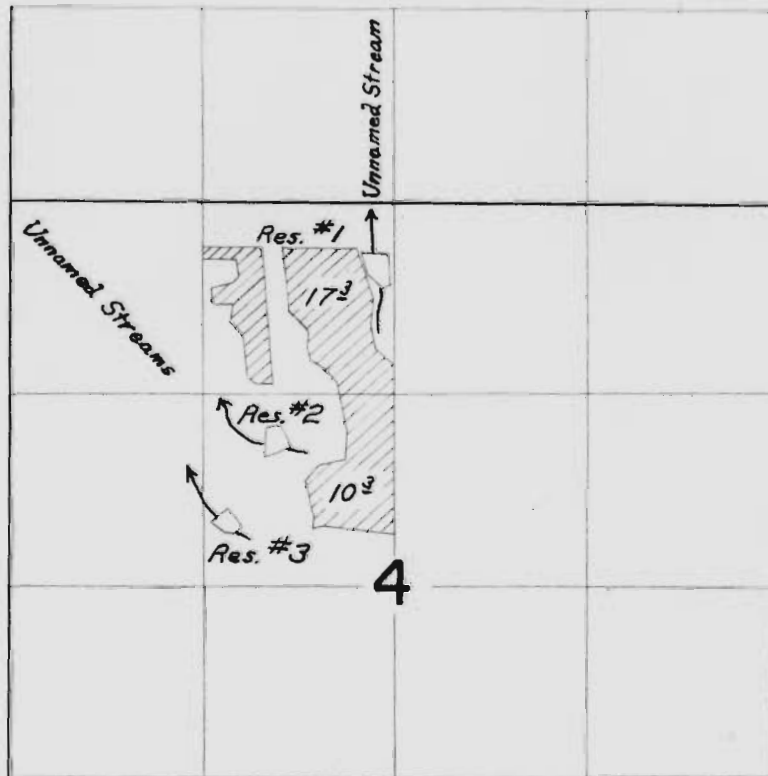

FINAL PROOF SURVEY
UNDER

Application No. ³¹¹¹² ~~A-31111~~ Permit No. ²⁴⁵⁴⁴ ~~A-1949~~
IN NAME OF

John Cunningham

Surveyed *May 17 1962* by *Thomas R. Lauer*