


T.4S.R.3E.W.M.

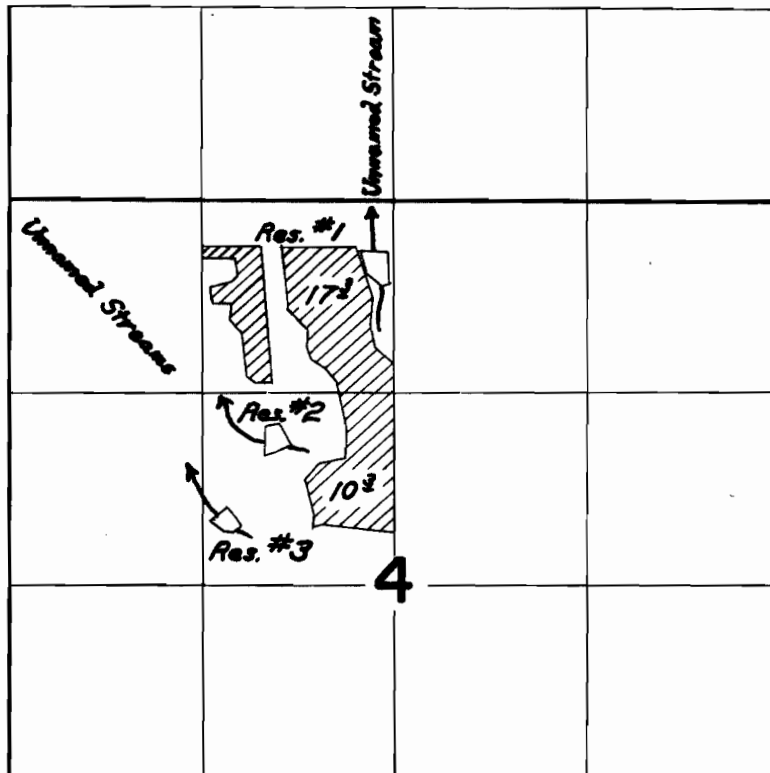

FINAL PROOF SURVEY
UNDER

Application No. 31112 Permit No. 24544
A-31111 A-1949
IN NAME OF

John Cunningham

Surveyed May 17 1962, by Thomas R. Lauer