


T.3S.R.1E.W.M.

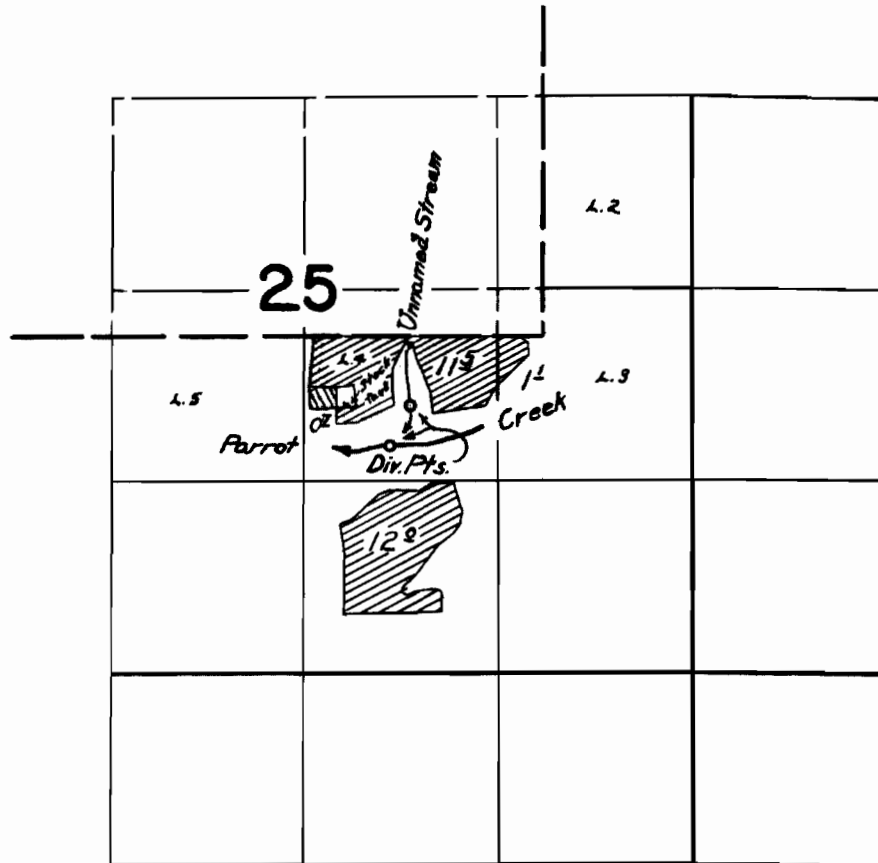


Unnamed Stream


Parrot Creek

FINAL PROOF SURVEY UNDER

Application No. *31928* Permit No. *25174*
IN NAME OF

Sidney J. Miles

Surveyed *June 21, 1962*, by *Thomas R. Lauer*