


T.2S.R.2E.W.M.

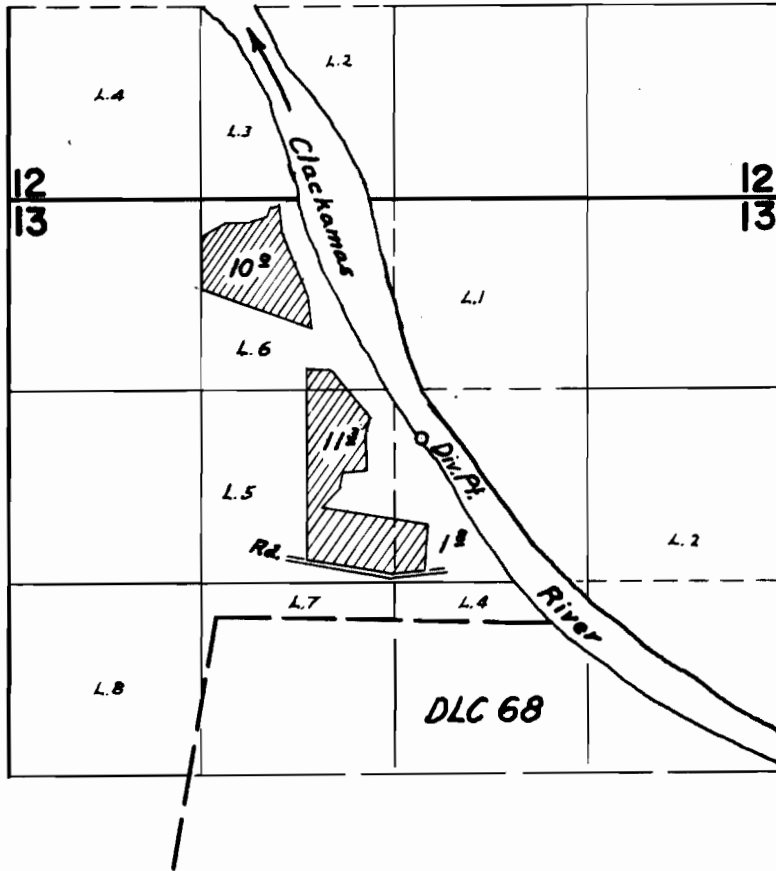

FINAL PROOF SURVEY
UNDER

Application No. 32667 Permit No. 25796
IN NAME OF

Mrs. A. R. Smith

Surveyed May 16, 1962, by Thomas B. Lauer