


# T.3S.R.1W.W.M.

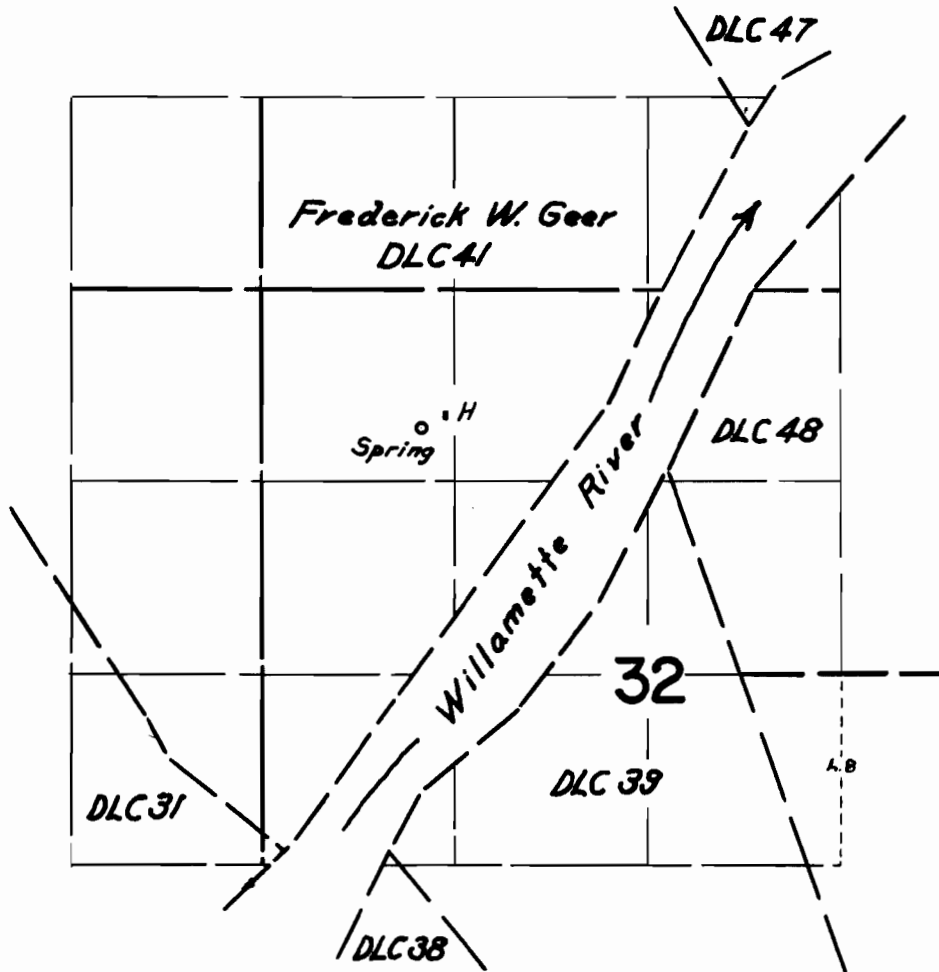

## FINAL PROOF SURVEY UNDER

Application No. 32795 Permit No. 25872  
IN NAME OF

J.A. Stone

Surveyed June 19, 1962, by Thomas R. Laner