


# T.5S.R.3E.W.M.

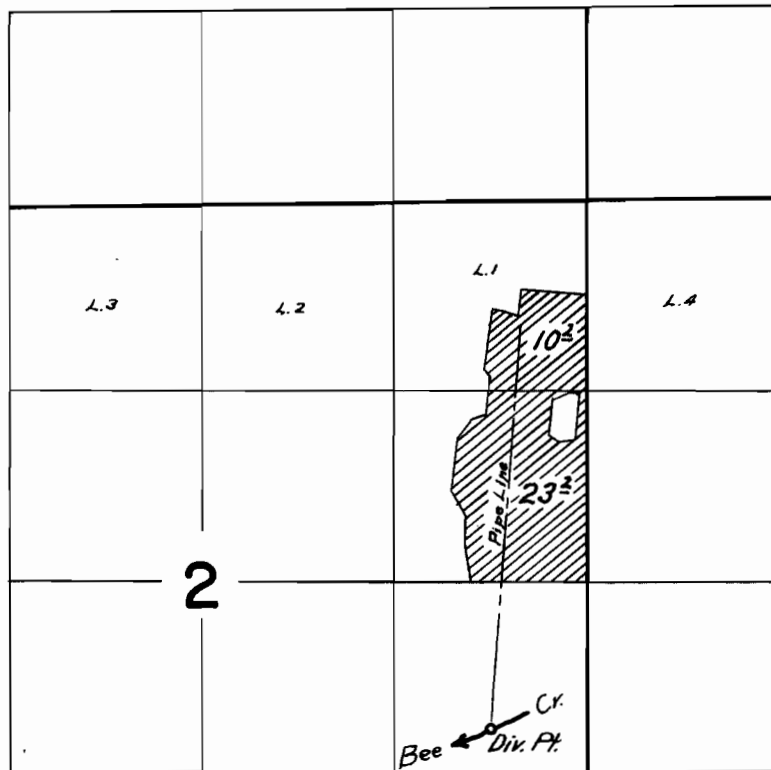

## FINAL PROOF SURVEY UNDER

Application No. 32860 Permit No. 26004  
IN NAME OF

Glenn Everett Brant

Surveyed June, 20, 1962, by Thomas R. Lauer