


T.2S.R.3E.W.M.

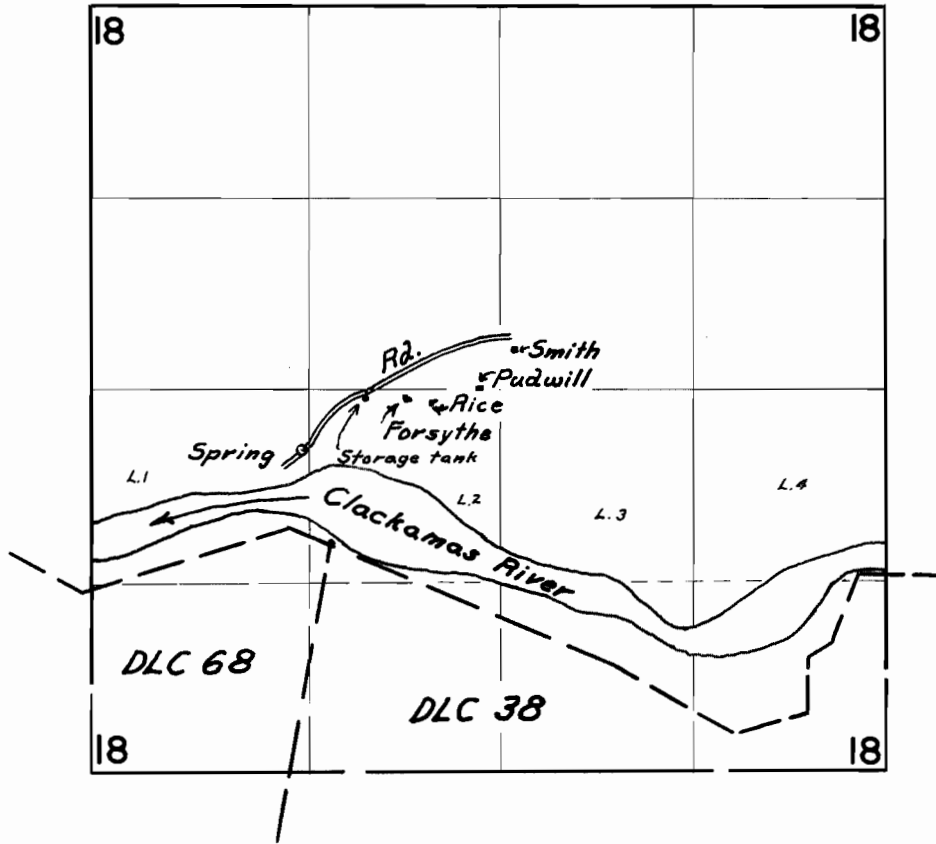

FINAL PROOF SURVEY  
UNDER

Application No. 33693 Permit No. 26634

IN NAME OF

Clyde H. Rice, Charles J. Smith  
+ Jack Forsythe

Surveyed April 25, 1962, by Thomas R. Lauer