


T.15S. R.16E.W.M.

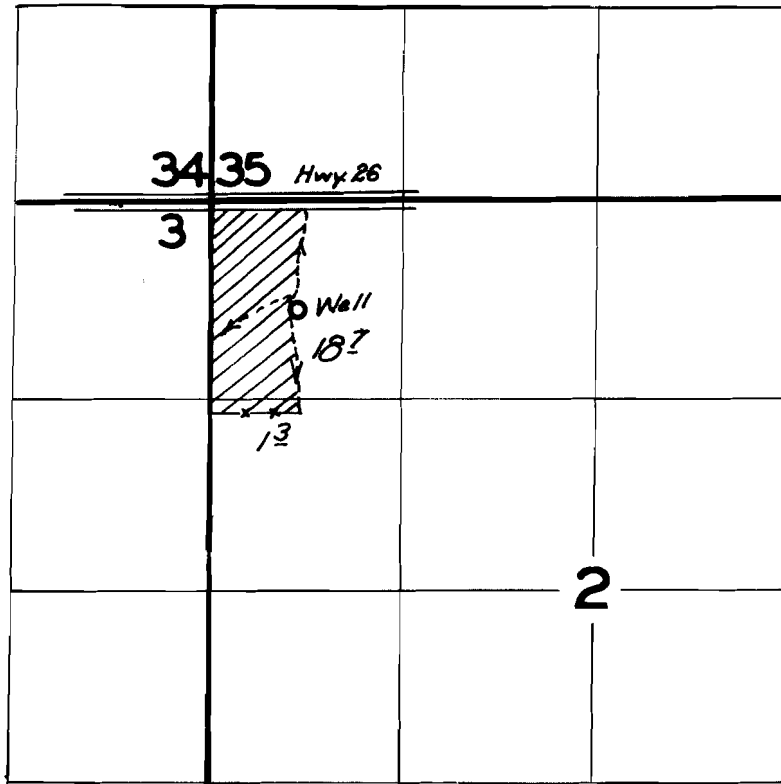

**FINAL PROOF SURVEY**  
UNDER

Application No. *G-1596*... Permit No. *G-1465*...  
IN NAME OF

*Pilot Butte Herford Ranch, Inc*

Surveyed *Nov. 1*... 19*62*, by *Carl R. Baker*.