

WATER RIGHT

DEPARTMENT OF AGRICULTURE

Scale 8 inches = 1 mile

OCHOCO SYSTEM

FOREST SERVICE


T.13 and 14 S. 19 E. Sec. show

OCHOCO RANGER STA Unit

FIELD MAP SHEET

Mag. Dec. Acres

(Case designation)

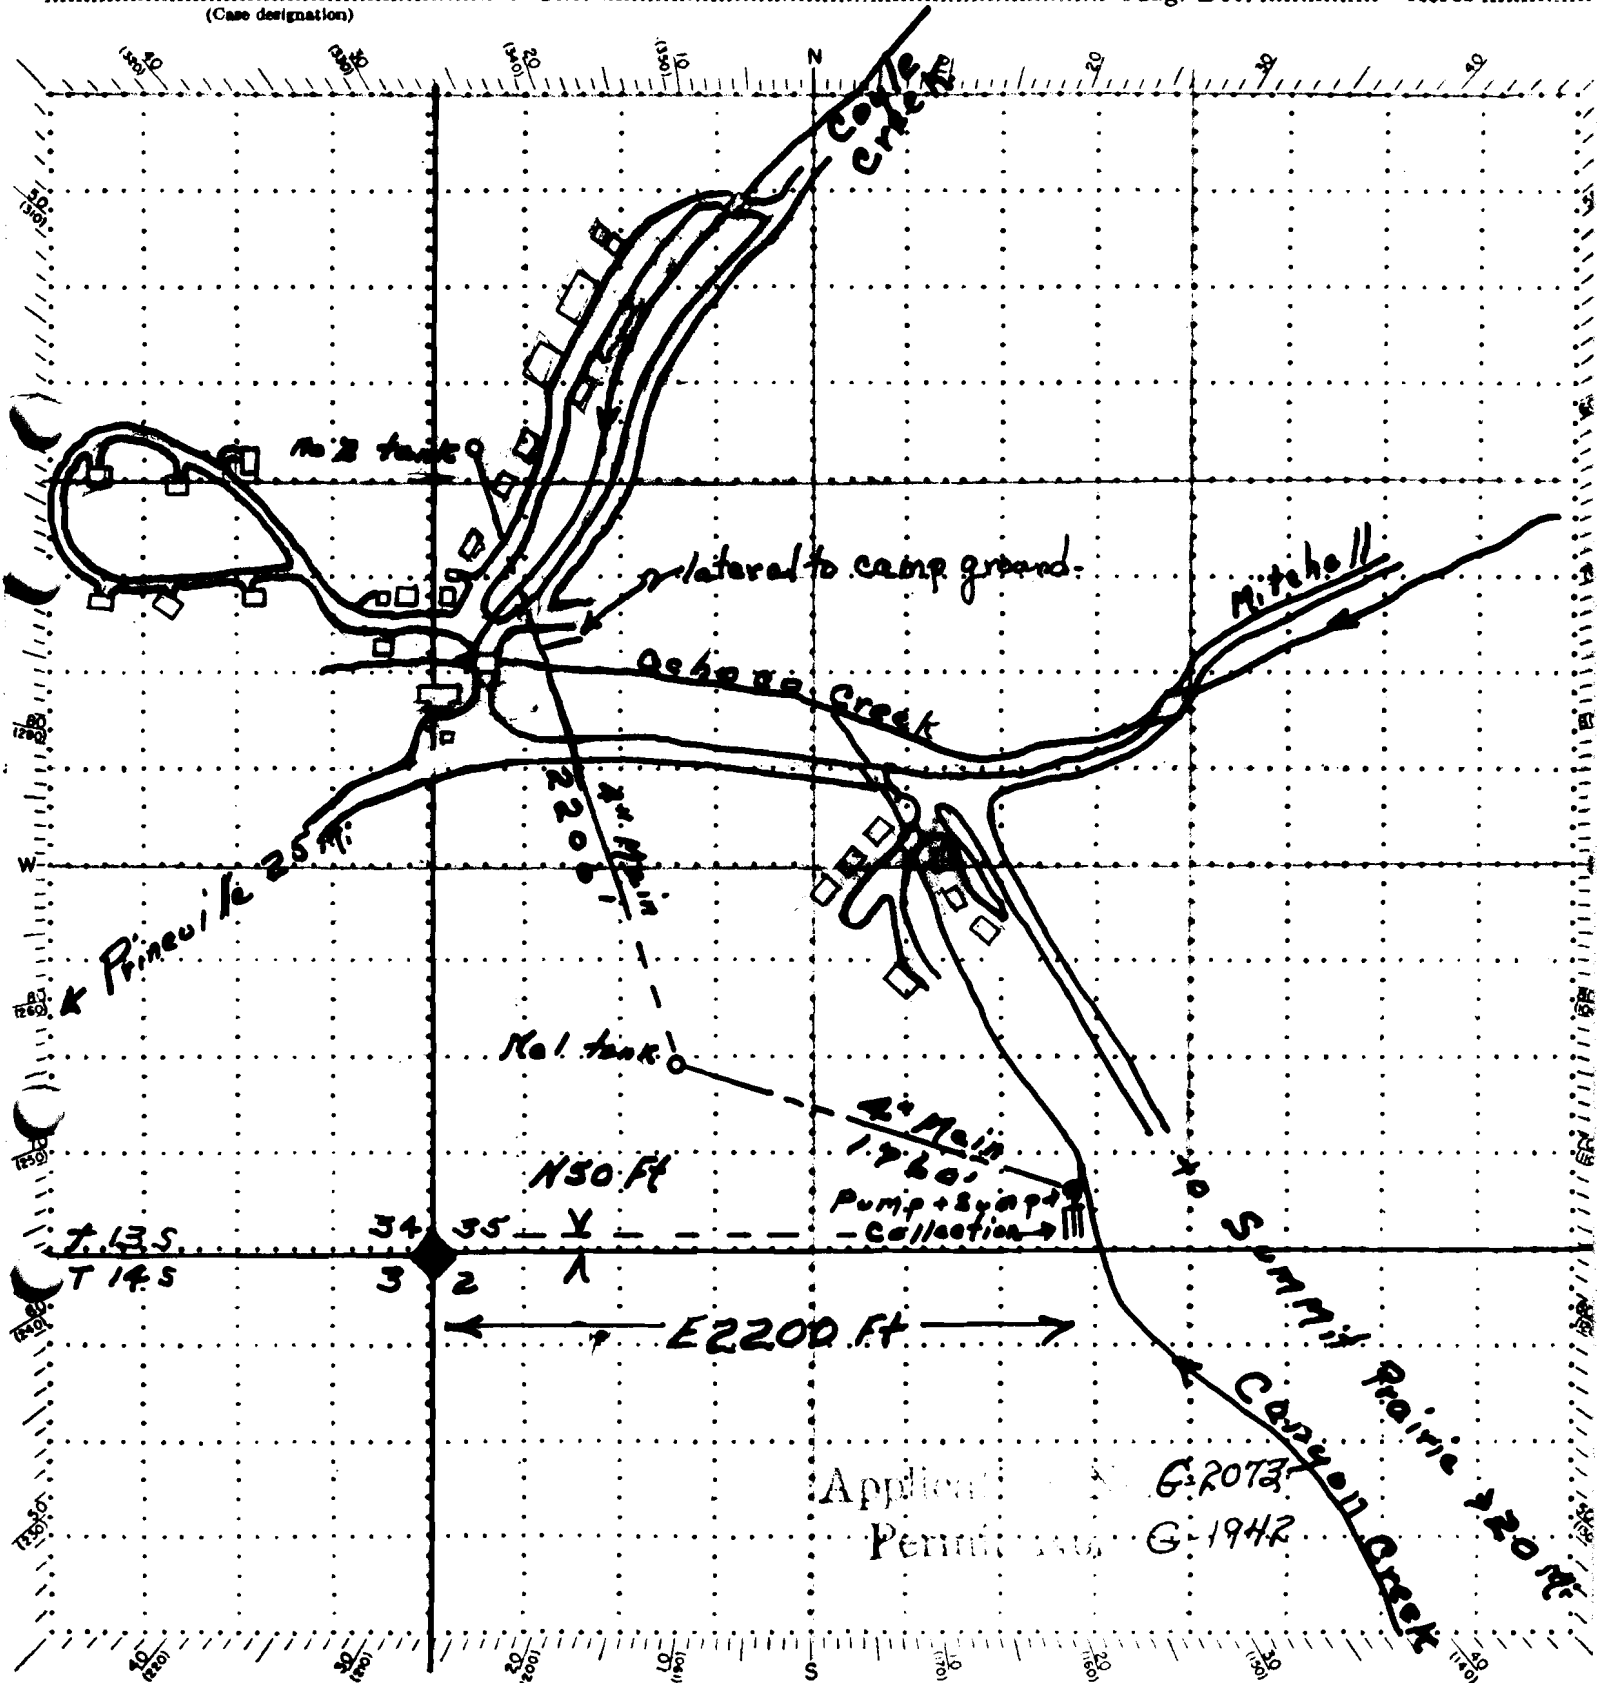

Approved: G-2073
Permit: G-1942

Field work by E. Hall Date July 1961 Platted by M.K. McCoy

Remarks

Approved 19

9-1942