


T.15S. R.15&16E.W.M.

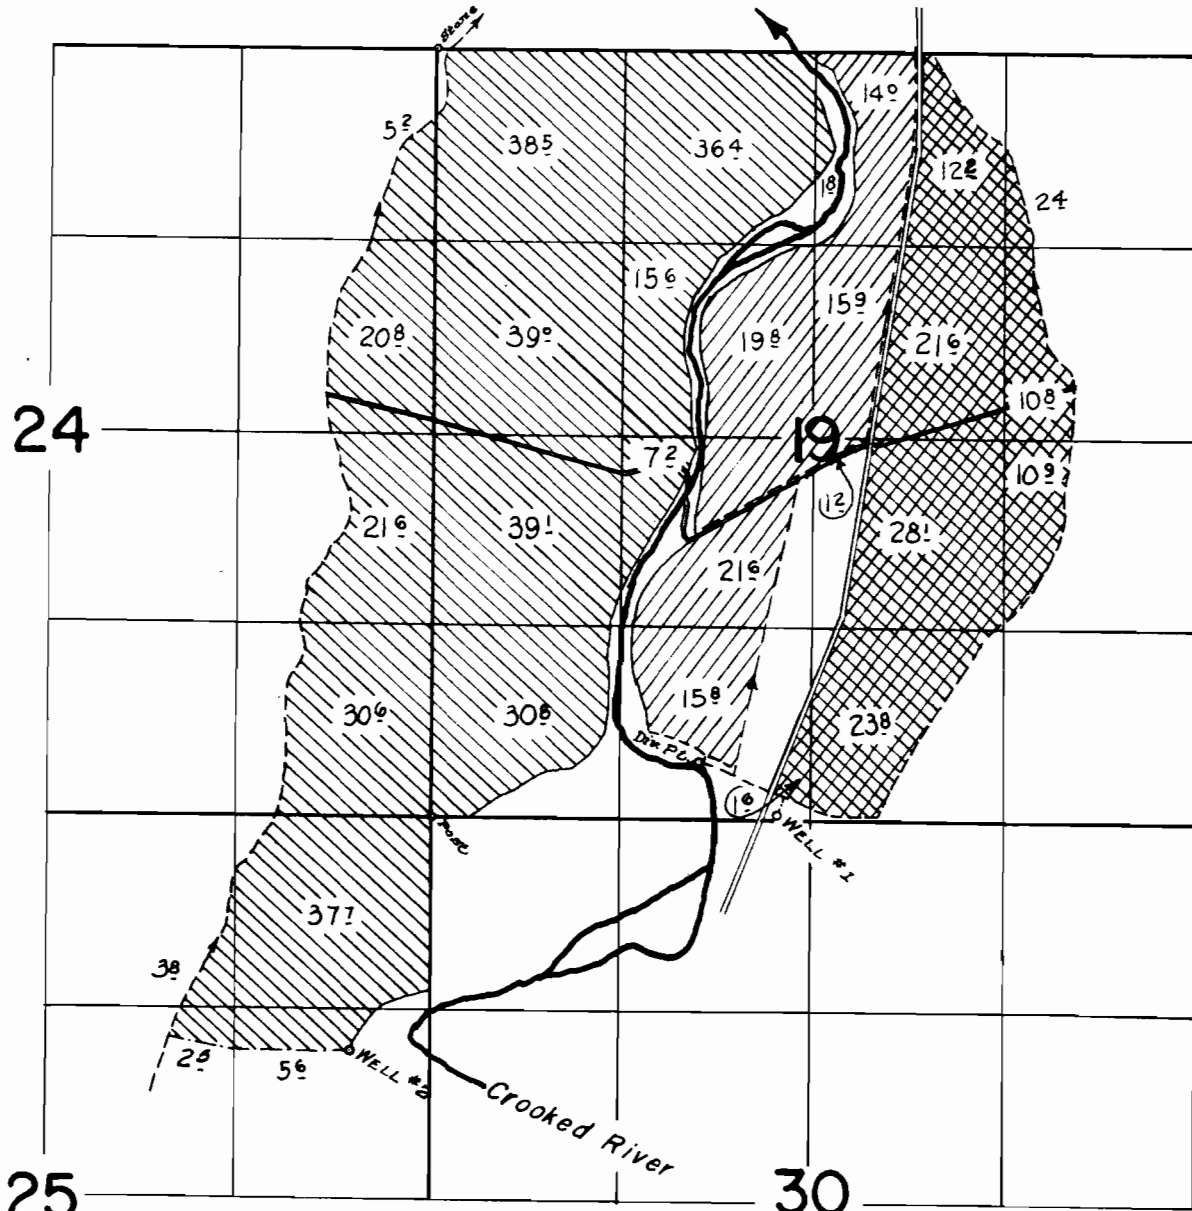

FINAL PROOF SURVEY
UNDER

Application No. 29845 Permit No. 23258
G-82 G-194
IN NAME OF

Hudspeth Land & Livestock Co.

Surveyed Sept. 28 1960, by *R.H. Jackson*