


T.15S. R.14E.W.M.

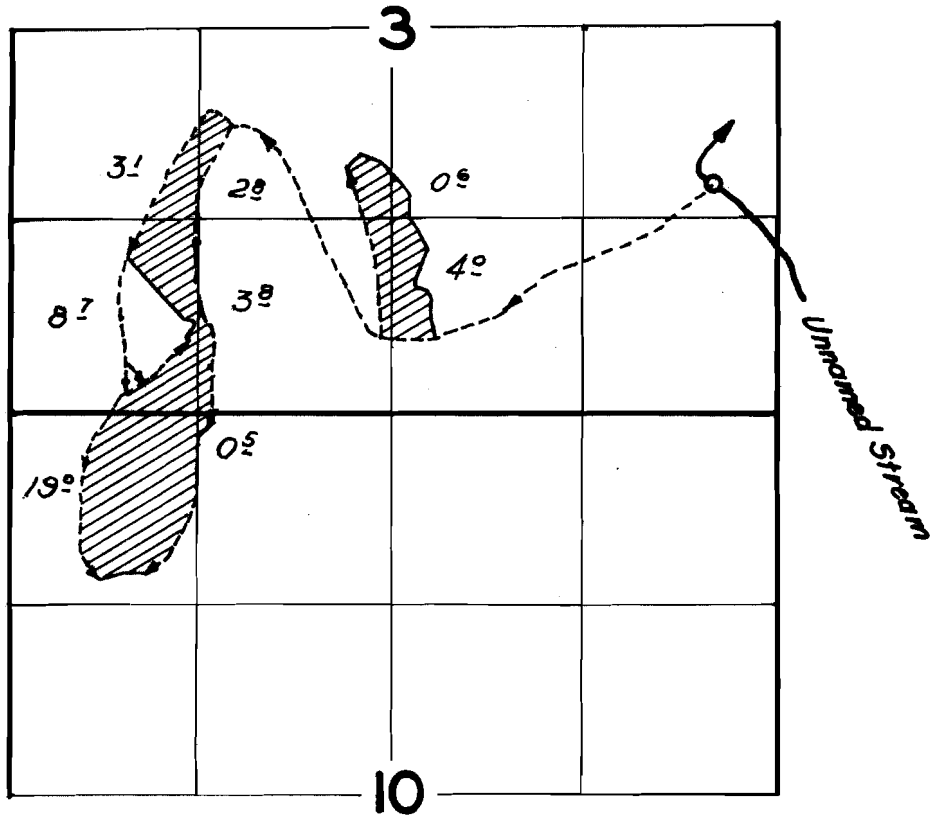

**FINAL PROOF SURVEY**  
UNDER

Application No. 30400. Permit No. 23889.  
IN NAME OF

*Eugene D. Hargis*

Surveyed October 31 1962, by *Ralph Jackson*