


Scale 1 in = 50 ft.

Aug. 1956

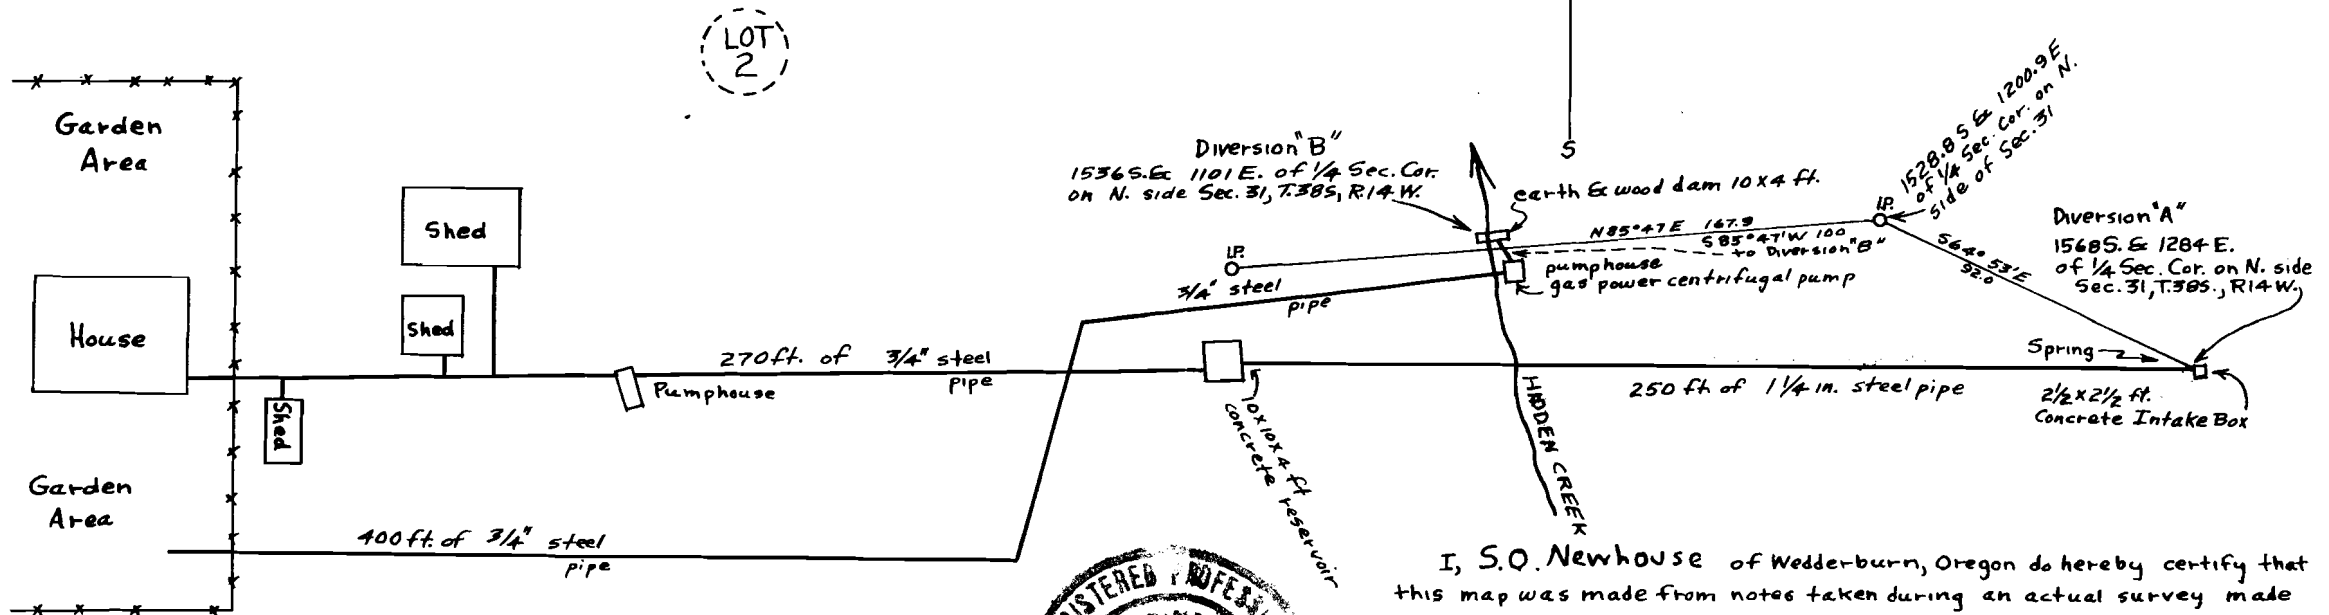

I, S.O. Newhouse of Wedderburn, Oregon do hereby certify that this map was made from notes taken during an actual survey made under my immediate supervision on July 9, 1956; that the monument shown on this map consisting of an iron pipe is 1528.85 ± 1200.9 E of the 1/4 Sec. Cor. on the North side of Sec. 31, T. 38 S., R. 14 W., N.M.

Application No. 32508
Permit No. 25771