


T. 17 S.R. 11 E.W.M.

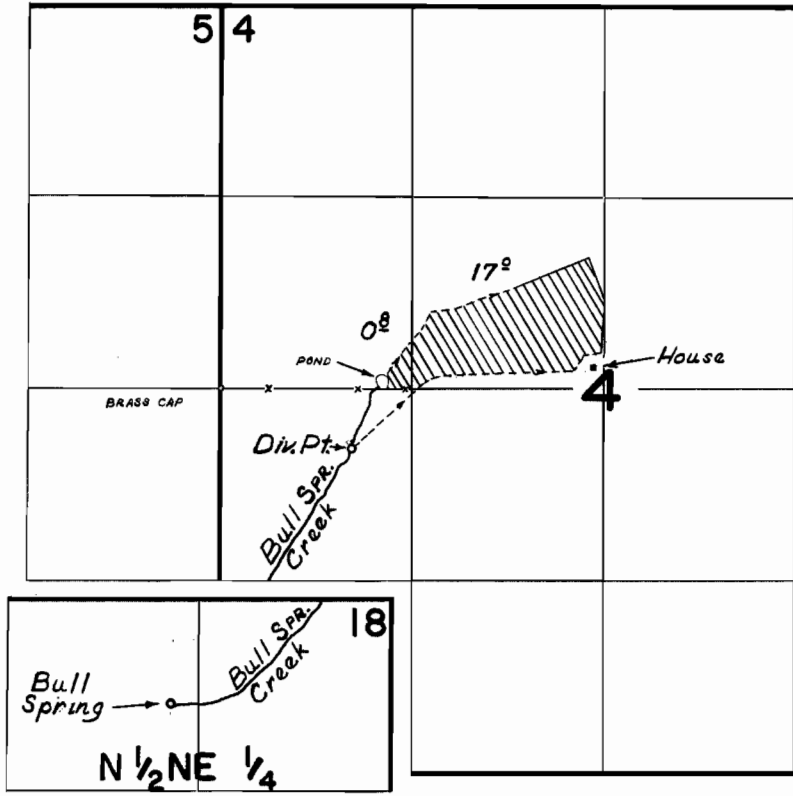

FINAL PROOF SURVEY
UNDER

Application No. 29645. Permit No. 24949.
IN NAME OF

MAHLON I. COUCH

Surveyed Oct. 23. 1962, by T.R. Lauer