


T. 15 S. R. 10 E. W. M.

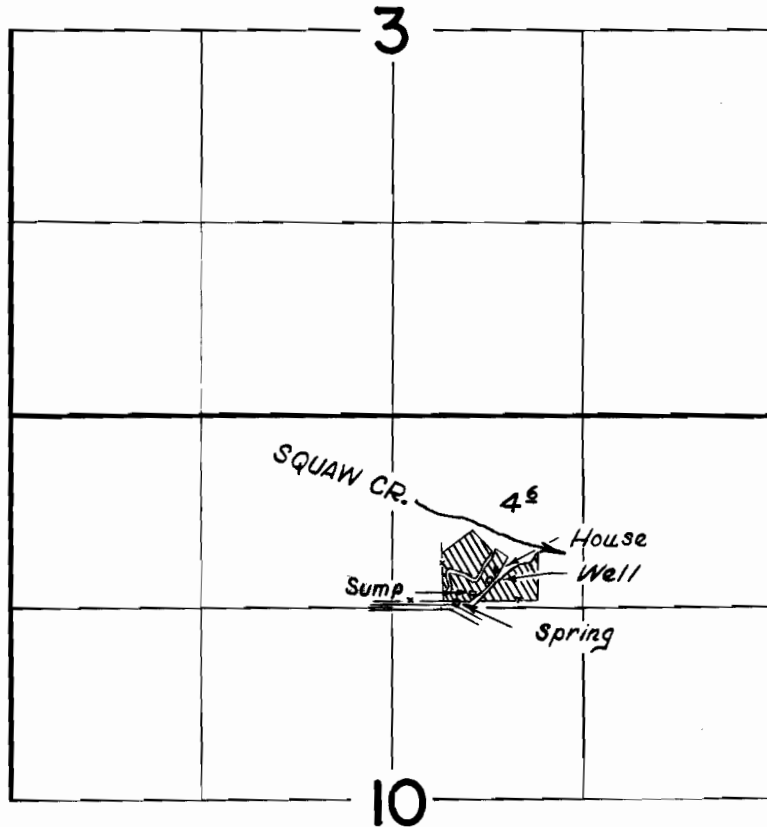

FINAL PROOF SURVEY
UNDER

Application No. *G-1718* 33877 Permit No. *G-1575* 26701
IN NAME OF

.....**CHARLES H. FARRER**.....

Surveyed *Oct. 29* 1962, by *R.H. Jackson*.