


# T. 28 S.R. 7 W.W.M.

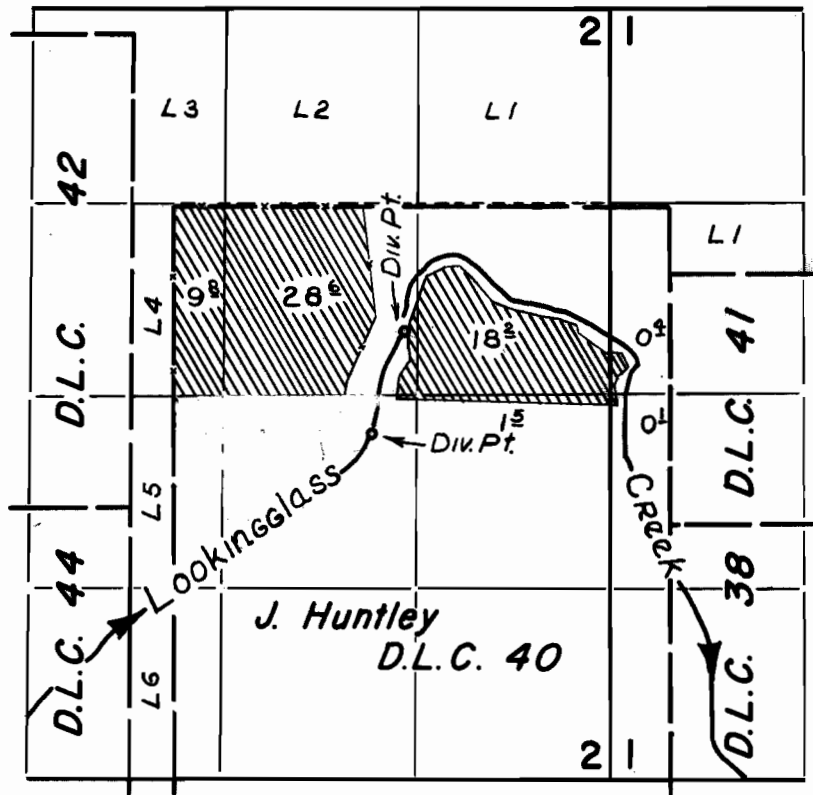

## FINAL PROOF SURVEY UNDER

Application No. 32811.. Permit No. 25902..  
IN NAME OF

**FRED SCHULZE**

Surveyed July 31 1962., by C.R. Baker.....