


T. 29 S.R. 4 W.W.M.

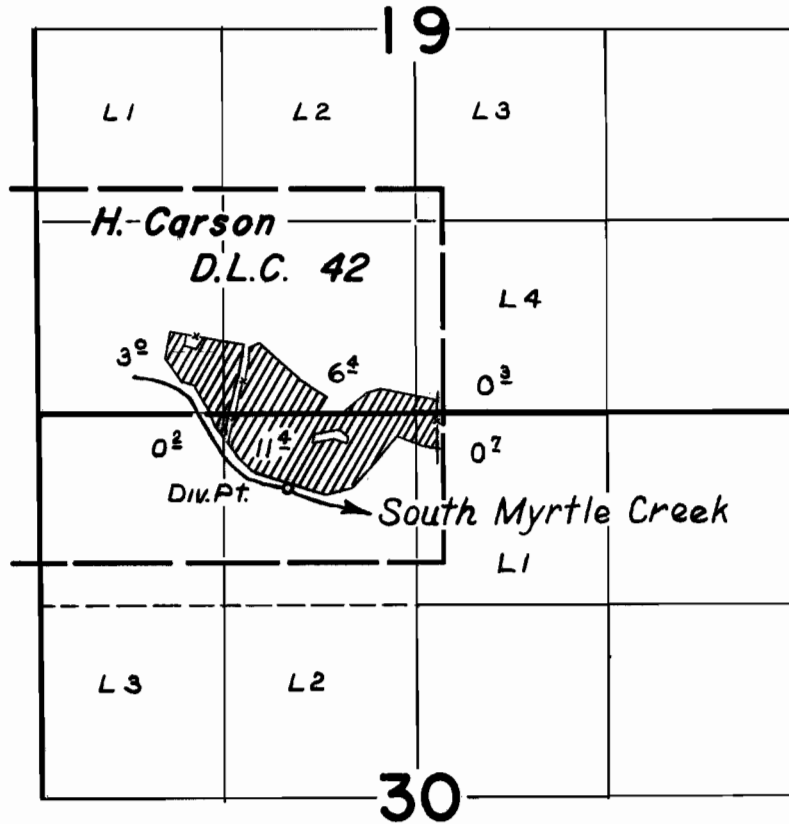

FINAL PROOF SURVEY
UNDER

Application No. 32914 Permit No. 26061.....
IN NAME OF

IRVING J. MACDONALD

Surveyed Aug. 2..... 1962., by C.R. Baker.....