


# T.29S.R.5W.W.M.

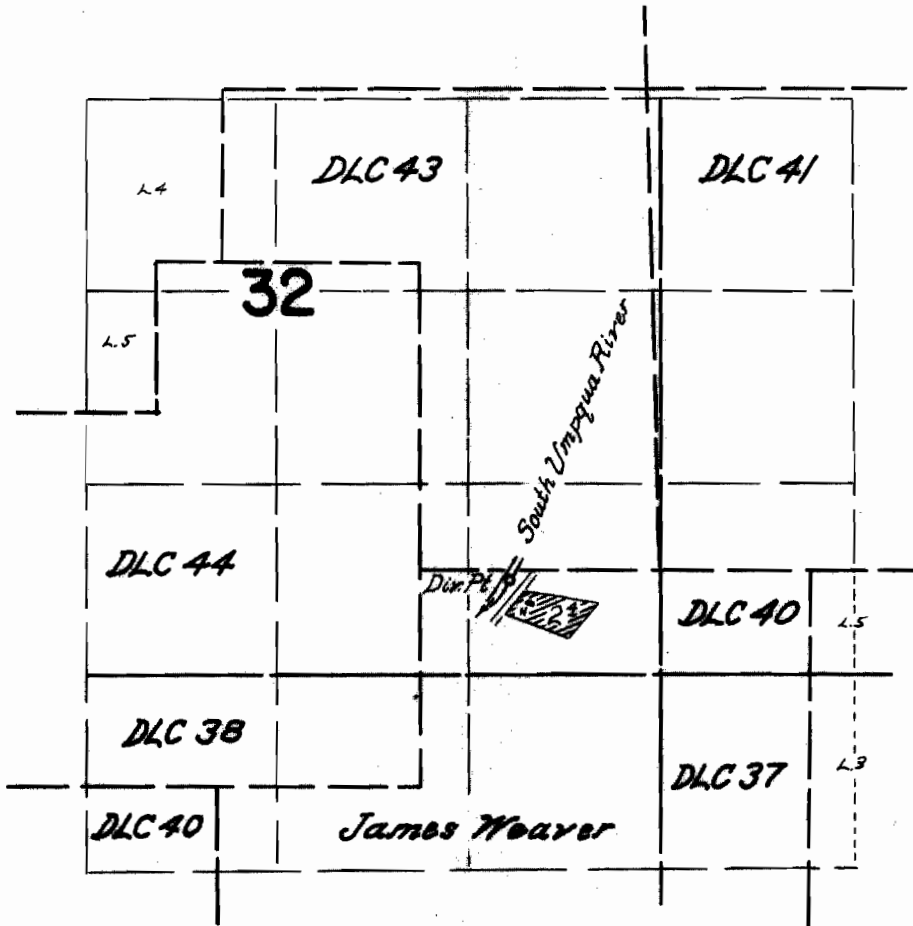

## FINAL PROOF SURVEY UNDER

Application No. 34004... Permit No. 26825.  
IN NAME OF

*Daniel H. Parolius*

Surveyed August 6 1962, by *Thomas R. Lauer*