


T. 28 S.R. 8 W.W.M.

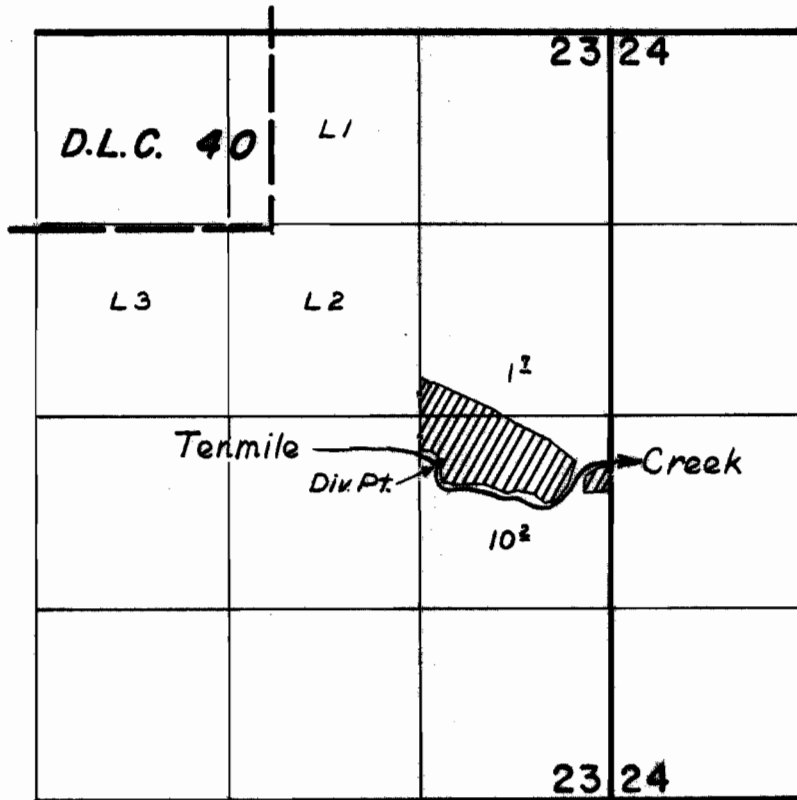

FINAL PROOF SURVEY
UNDER

Application No. 34145 Permit No. 26904
IN NAME OF

LLOYD E. THOMAS

Surveyed Aug. 1 1962, by C. R. Baker