


T.31S.R.6W.W.M.

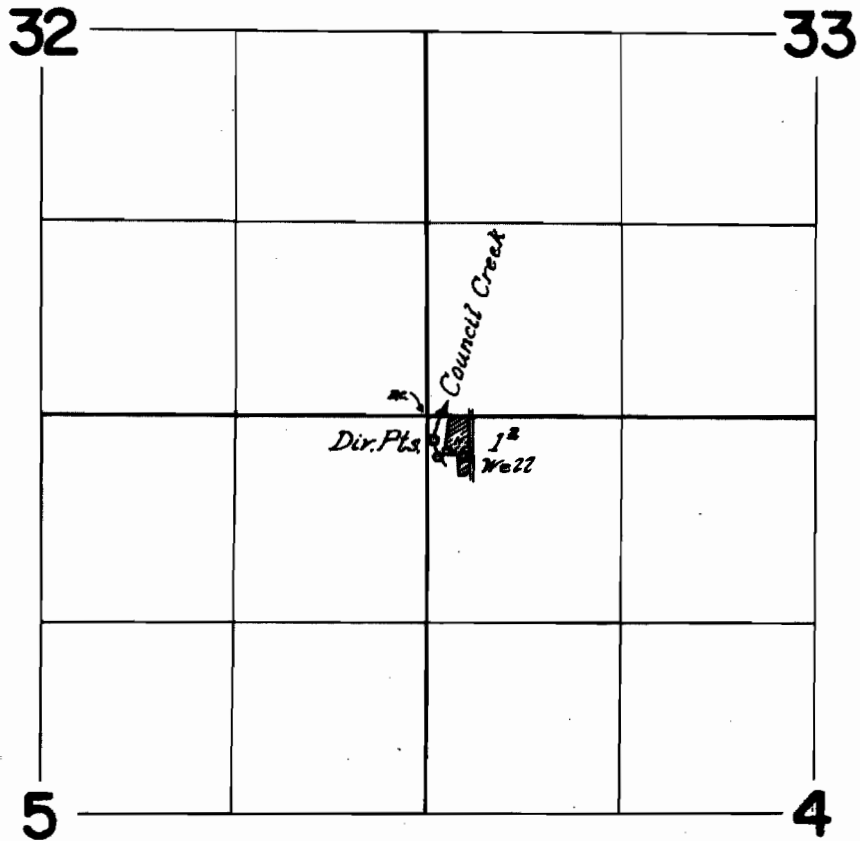

FINAL PROOF SURVEY
UNDER

Application No. *34279* Permit No. *26973*
IN NAME OF

Dorney J. Pearson

Surveyed *August 1, 1962*, by *Thomas R. Lauer*