


G-1716
G-1716
30948

T. 12S. R. 26E. W.M.

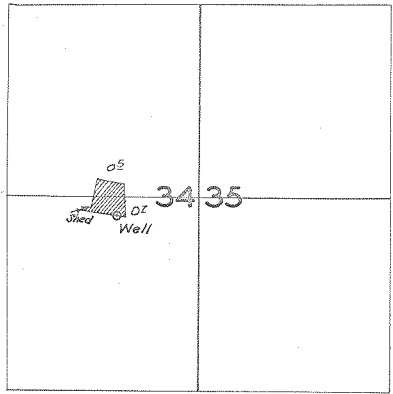

Scale 8" = 1 mile

FINAL PROOF SURVEY
UNDER

Application No. *G-1813* Permit No. *G-1716*...
IN NAME OF

Dayville Cemetery Board

Surveyed *Nov. 12, 1962*, by *Ralph Jackson*