


Per 26059
30949

T.11S. R.30E.W.M.

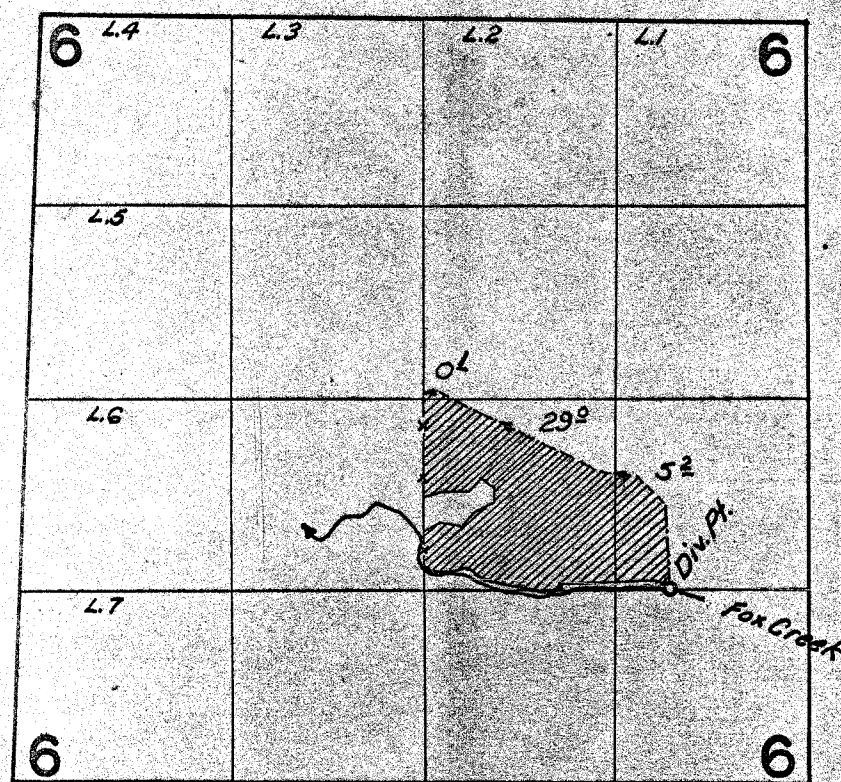

FINAL PROOF SURVEY
UNDER

Application No. 32880... Permit No. 26059.
IN NAME OF

Frank B. McGirr

Surveyed Nov. 10... 1962, by Ralph Jackson