


Per 26115
30950

T.11S. R.30E.W.M.

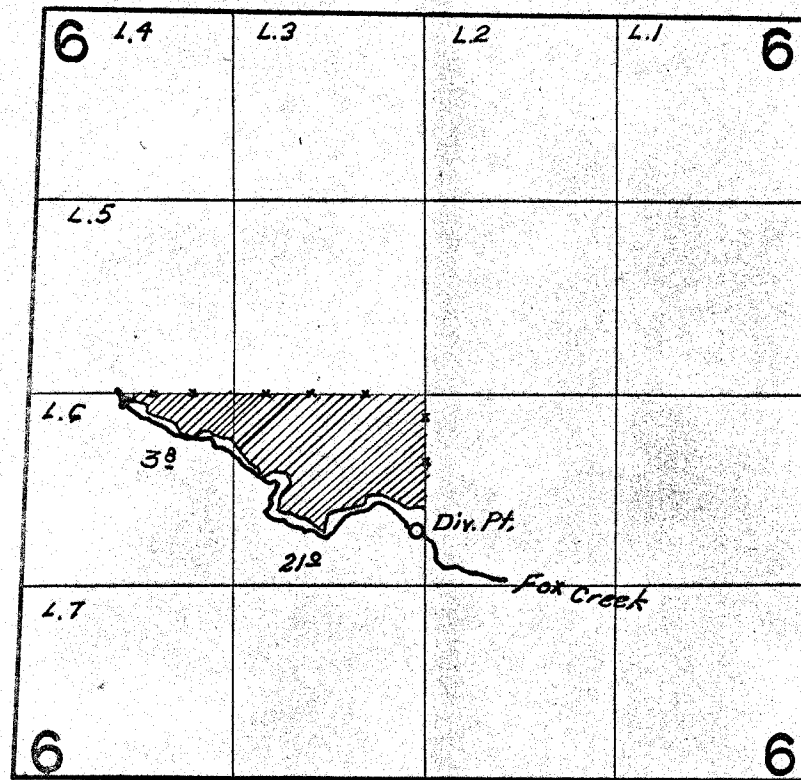

FINAL PROOF SURVEY UNDER

Application No. 32881... Permit No. 26115...
IN NAME OF

.....Max Justice.....

Surveyed Nov. 10... 1962, by Ralph Jackson