


TWP.39S, R3W,WM.SEC.28

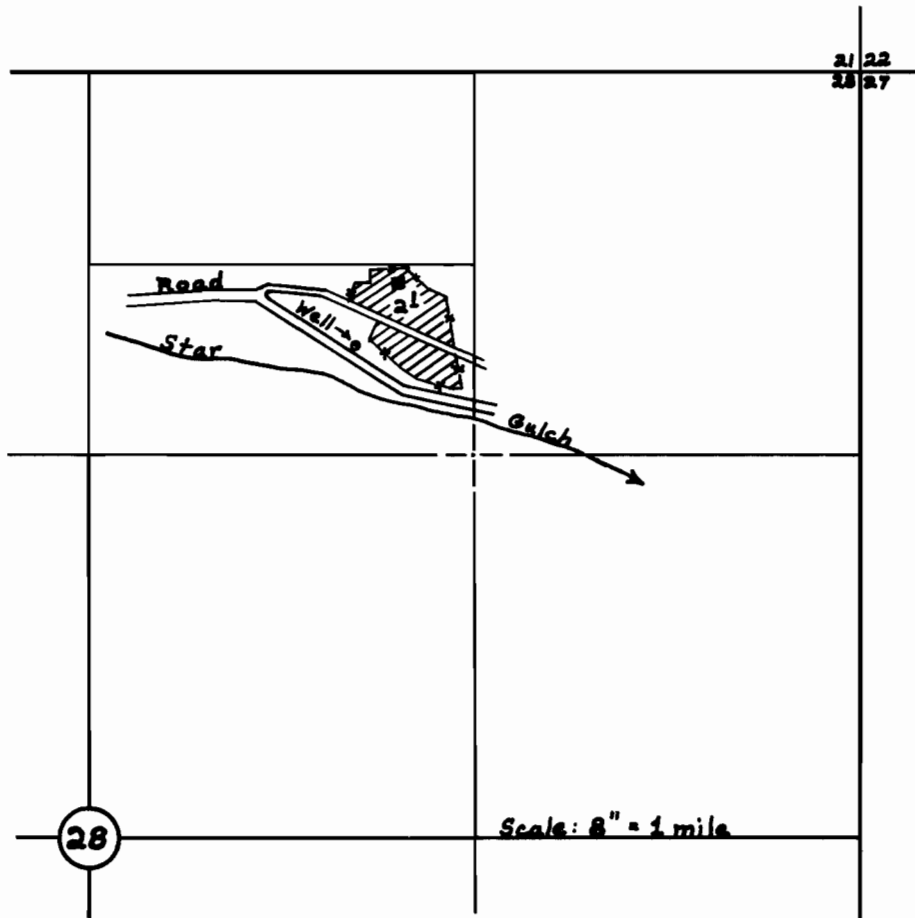

FINAL PROOF SURVEY
UNDER

Application No. G-1560... Permit No. G-1430..
IN NAME OF

Elva L. & Thelma E. Adams

Surveyed Jan. 18..... 1963., by D. C. Hendrix