


T 35 S. R 2 W W M SEC 29

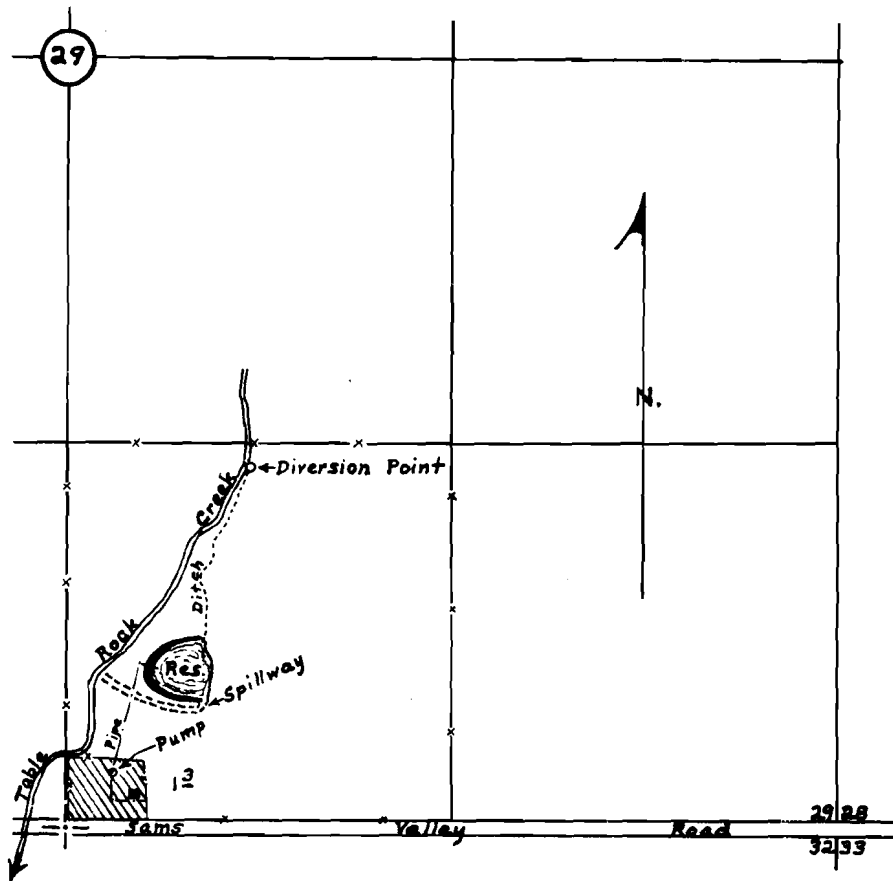

FINAL PROOF SURVEY UNDER

R-33460 R-2291
Application No. 33461 Permit No. 26439
IN NAME OF

Albert H. Harrison

Surveyed Jan 11 19 63, by DC Hendrix

Scale: 8" = 1 mile