


T 35 S R 2 W W M SEC 32

RECEIVED
JAN 22 1963
STATE ENGINEER
SALEM, OREGON

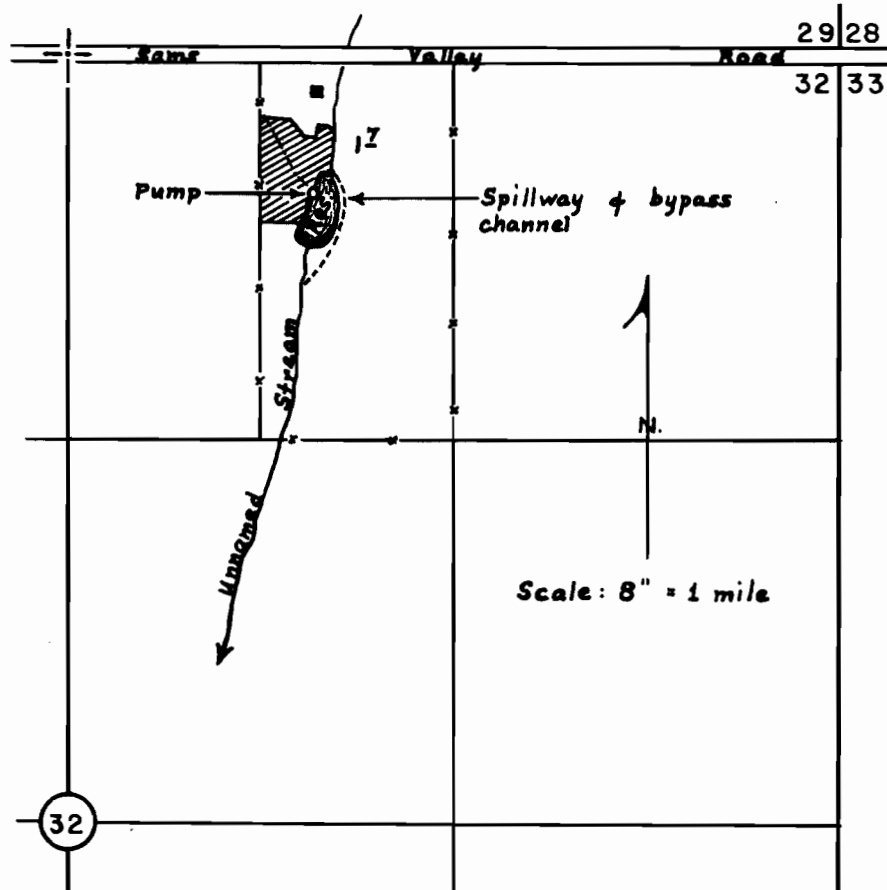

FINAL PROOF SURVEY
UNDER

R-34621 R-2589
Application No. 34622 Permit No. 27201
IN NAME OF

S.A. Nelson

Surveyed Jan. 11, 1963, by D.C. Hendrix