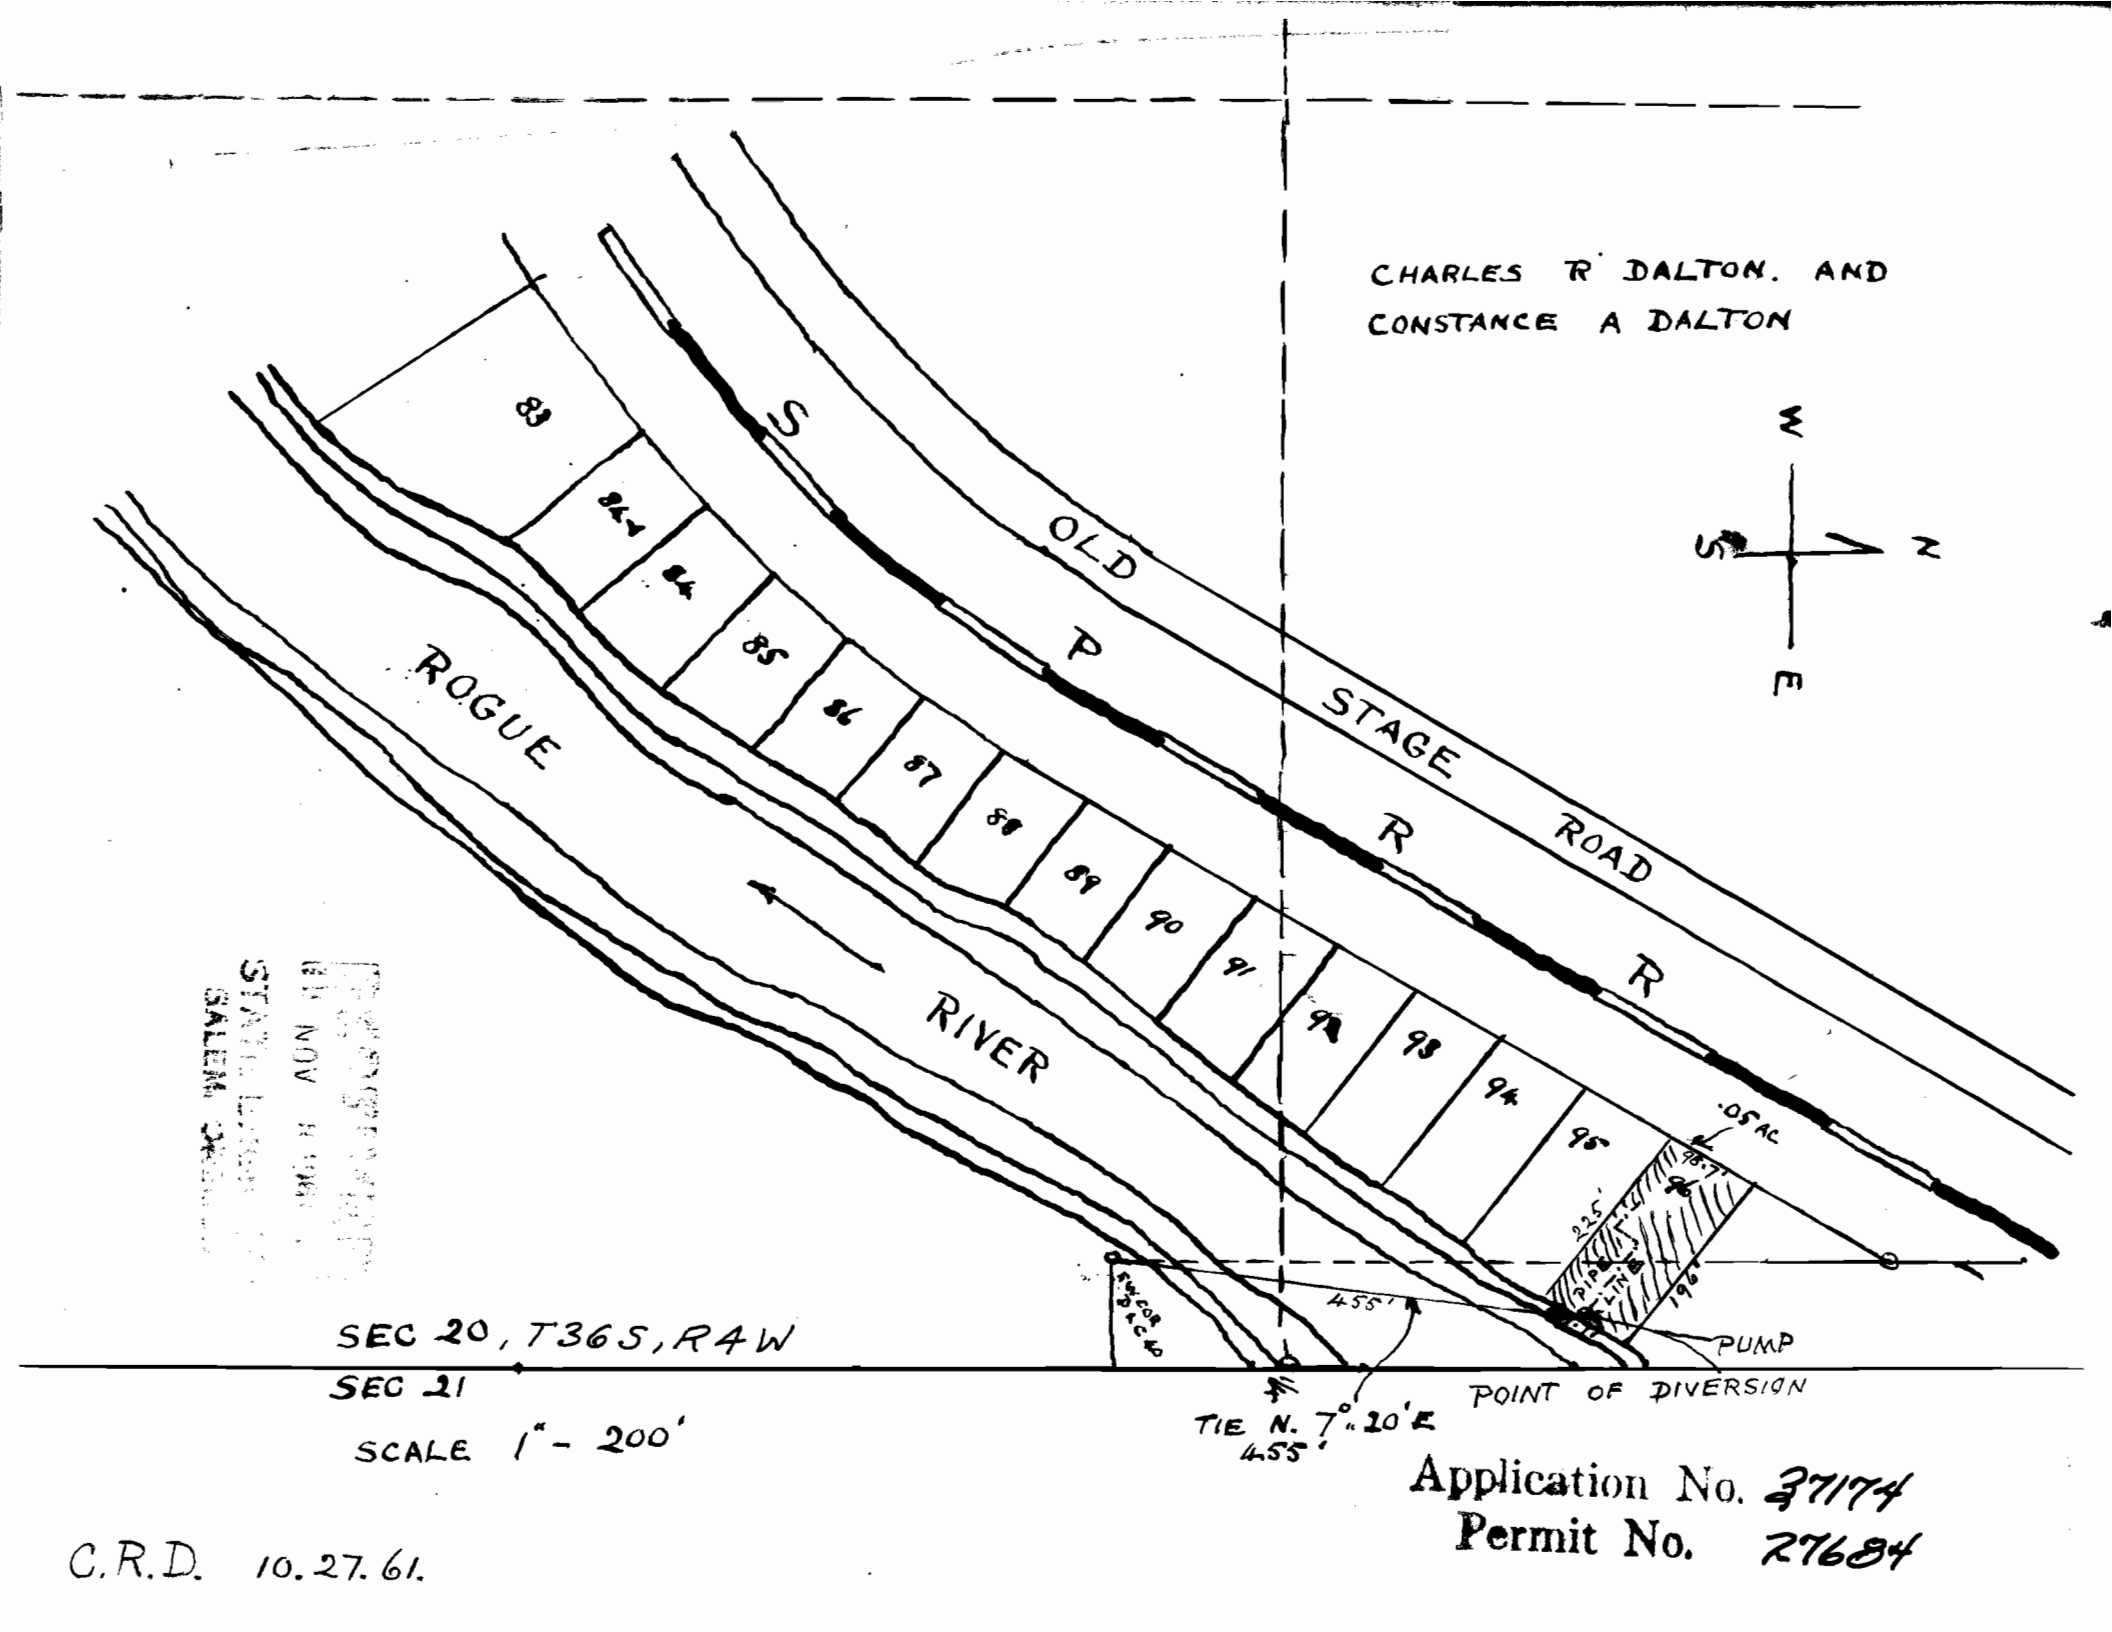


Application No. 37174
Permit No. 27684

C.R.D. 10.27.61.